


T.9S.R.6W.W.M.

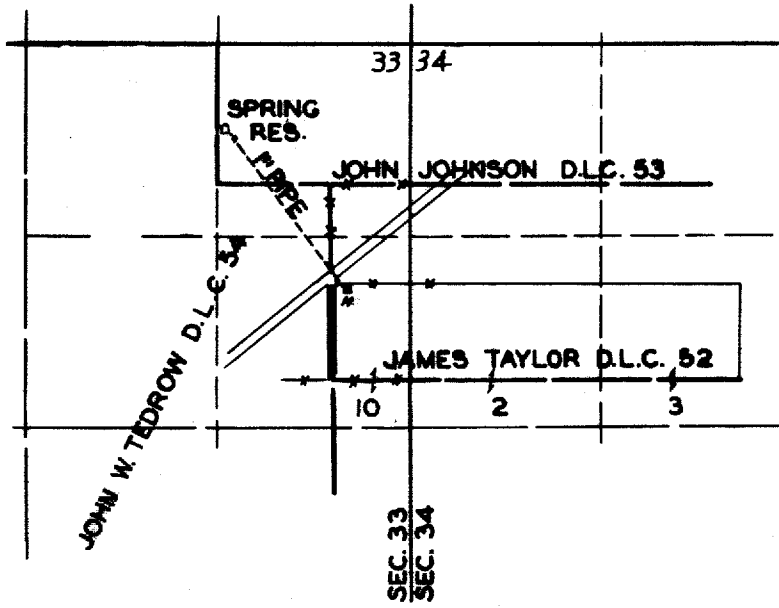

FINAL PROOF SURVEY
UNDER

Application No. ~~23642~~ Permit No. ~~18648~~
IN NAME OF

MRS. LAURA M. TRUEAX

Surveyed MAY 13, 1949, by H.L. COFFMAN