


# T.4 | S.R.13W.W.M.

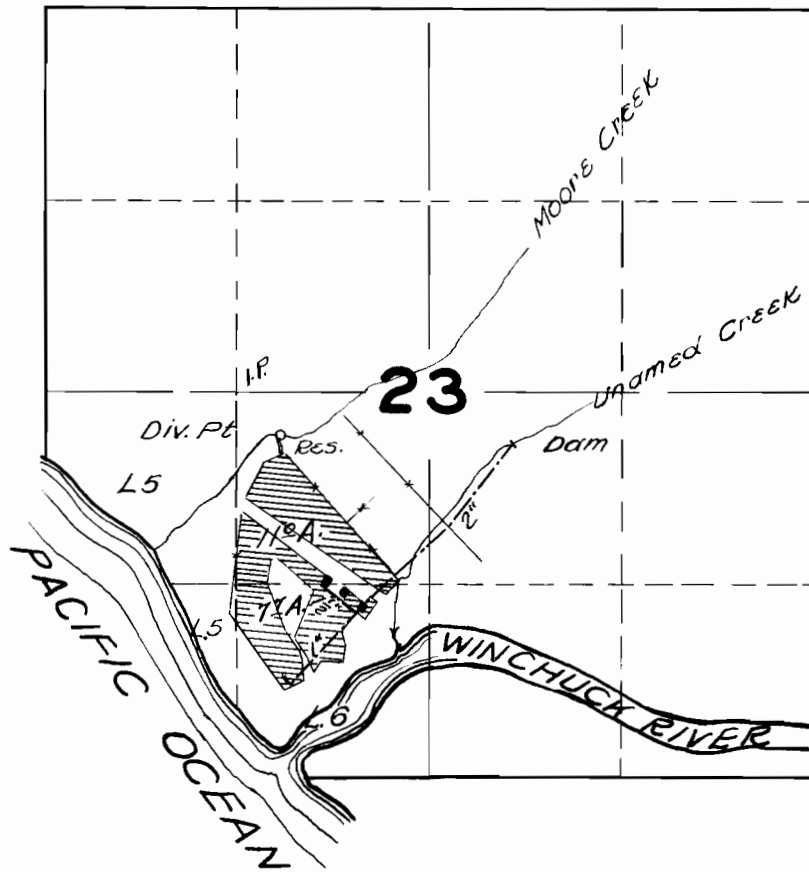

## FINAL PROOF SURVEY

UNDER

R\_16941

R\_706

Application No. 16942 Permit No. 12648

IN NAME OF

ENOS A. & RENAK POTTS

Surveyed AUG. 11. 1949. by H.L. COFFMAN.