


2
T.18S.R.1W.W.M.

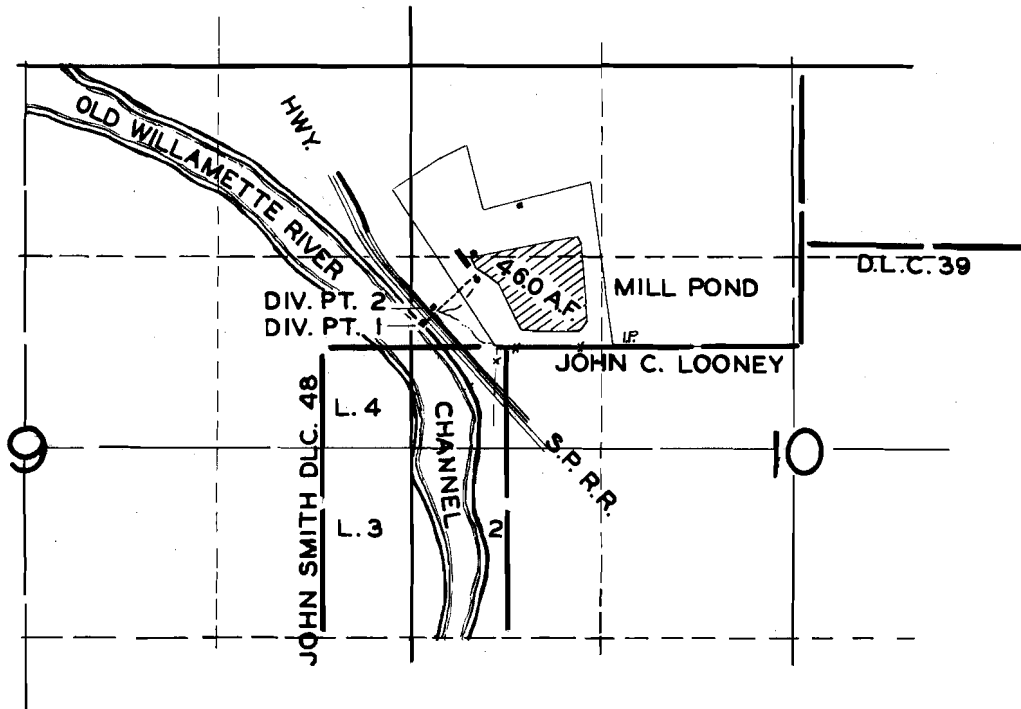

FINAL PROOF SURVEY

UNDER

R. 22932

R. 917

Application No. 22933 Permit No. 18077

IN NAME OF

MT. JUNE FOREST PRODUCTS CO.

Surveyed JUNE 1, 1949, by H.L. COFFMAN.