


T.28S.R.8W.W.M.

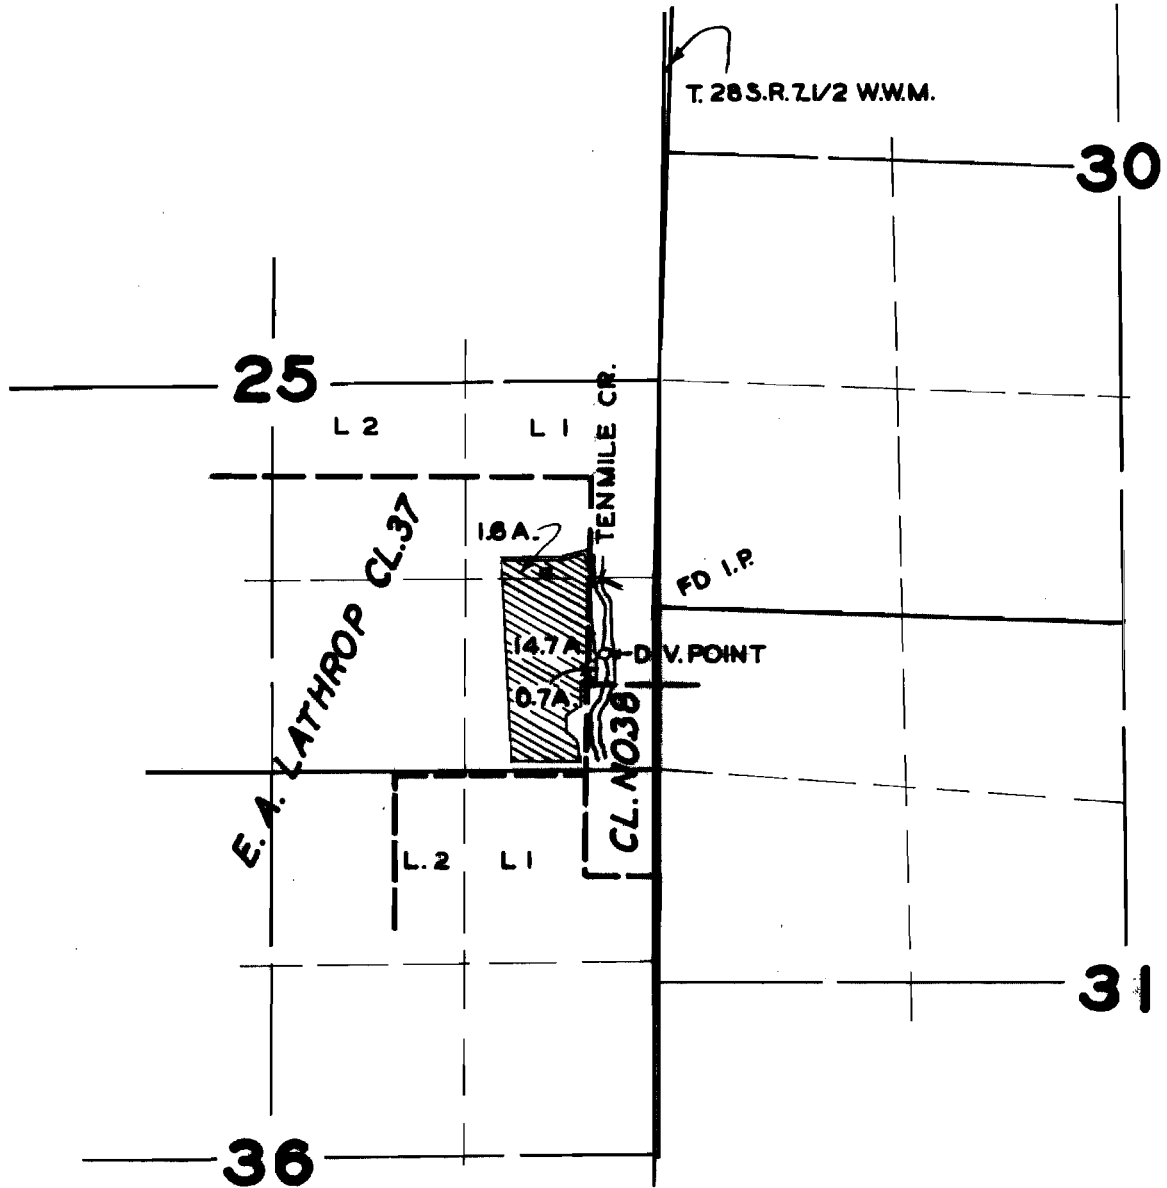

FINAL PROOF SURVEY UNDER

Application No. 20016.. Permit No. 15587
IN NAME OF

E. E. THOMSON

Surveyed JULY 6, 1949, by H.L. COFFMAN