


Sec. 35, Tp 3N, Range 10 E.W.M.

Lot 4 Adams Paradise
Acreage Now Known as Moun-
tain View Addition to
Hood-River.

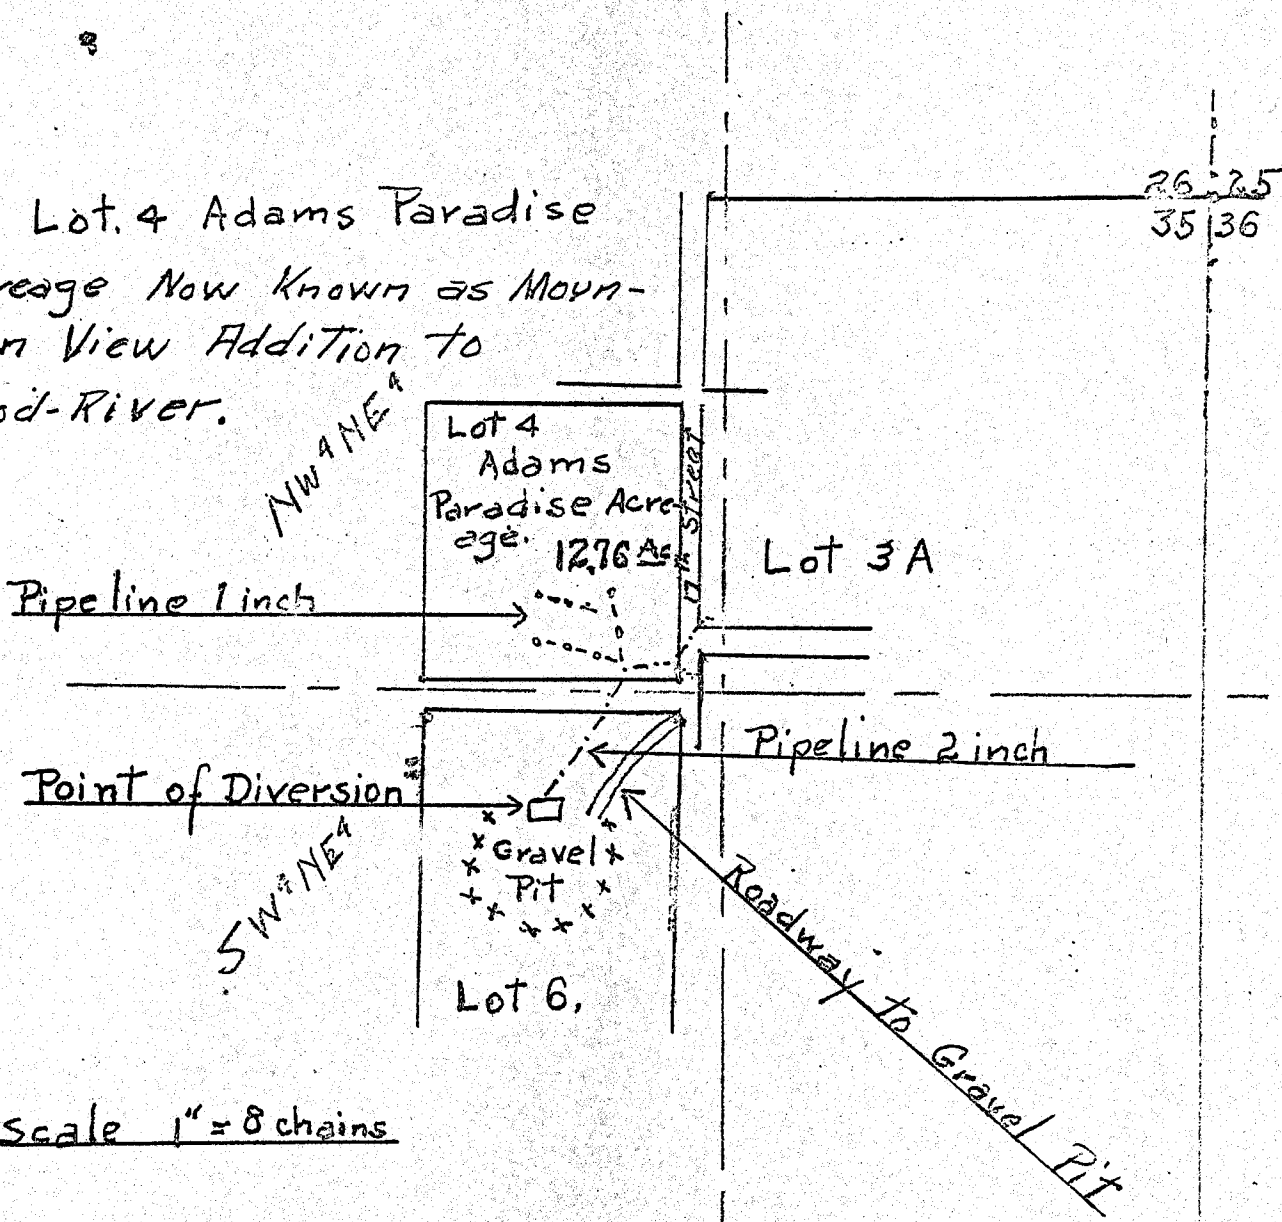

Scale 1" = 8 chains

Application No. 16876

Permit No. 12633

4-5-16876-er