


T.24 S. R.5 W.W.M.

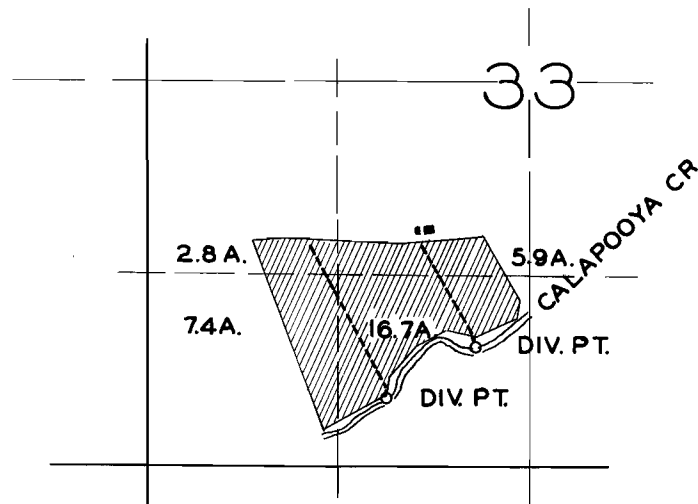

FINAL PROOF SURVEY UNDER

Application No. *18608*... Permit No. *14247*.
IN NAME OF

W.G. TRUITT

Surveyed JULY 20 1949, by H.L. COFFMAN