


**T.19S.R.4W.W.M.**

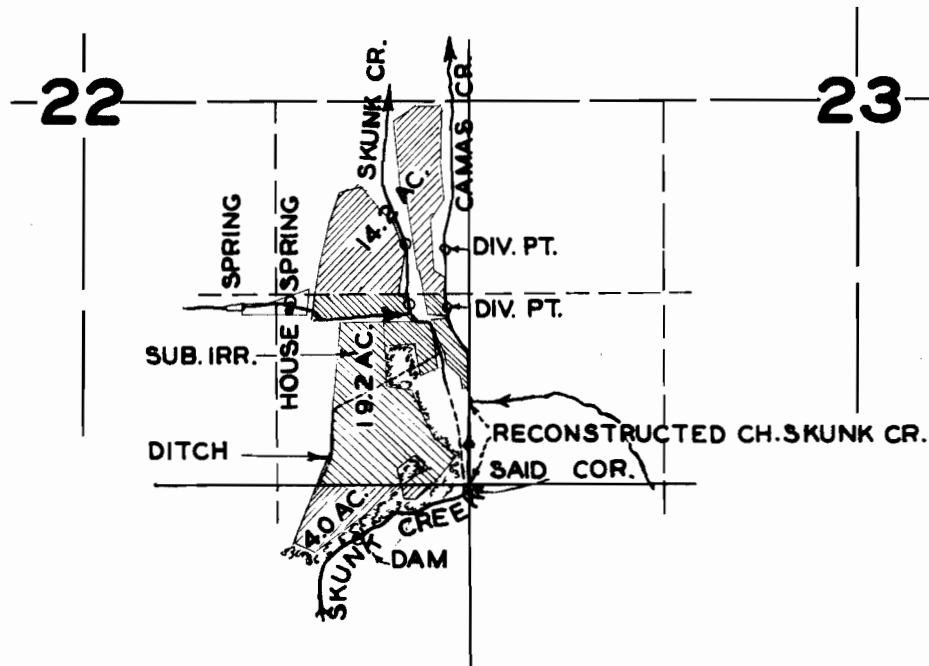

**FINAL PROOF SURVEY**  
**UNDER**

Application No. 20410... Permit No. 15910...  
IN NAME OF

..... C.R. NAPPER .....

Surveyed JUNE 20 1949, by H.L. COFFMAN...