


T. 34 S., R. 8 W., W. 1 M.
Scale 8" = 1 Mile Jan. 1947

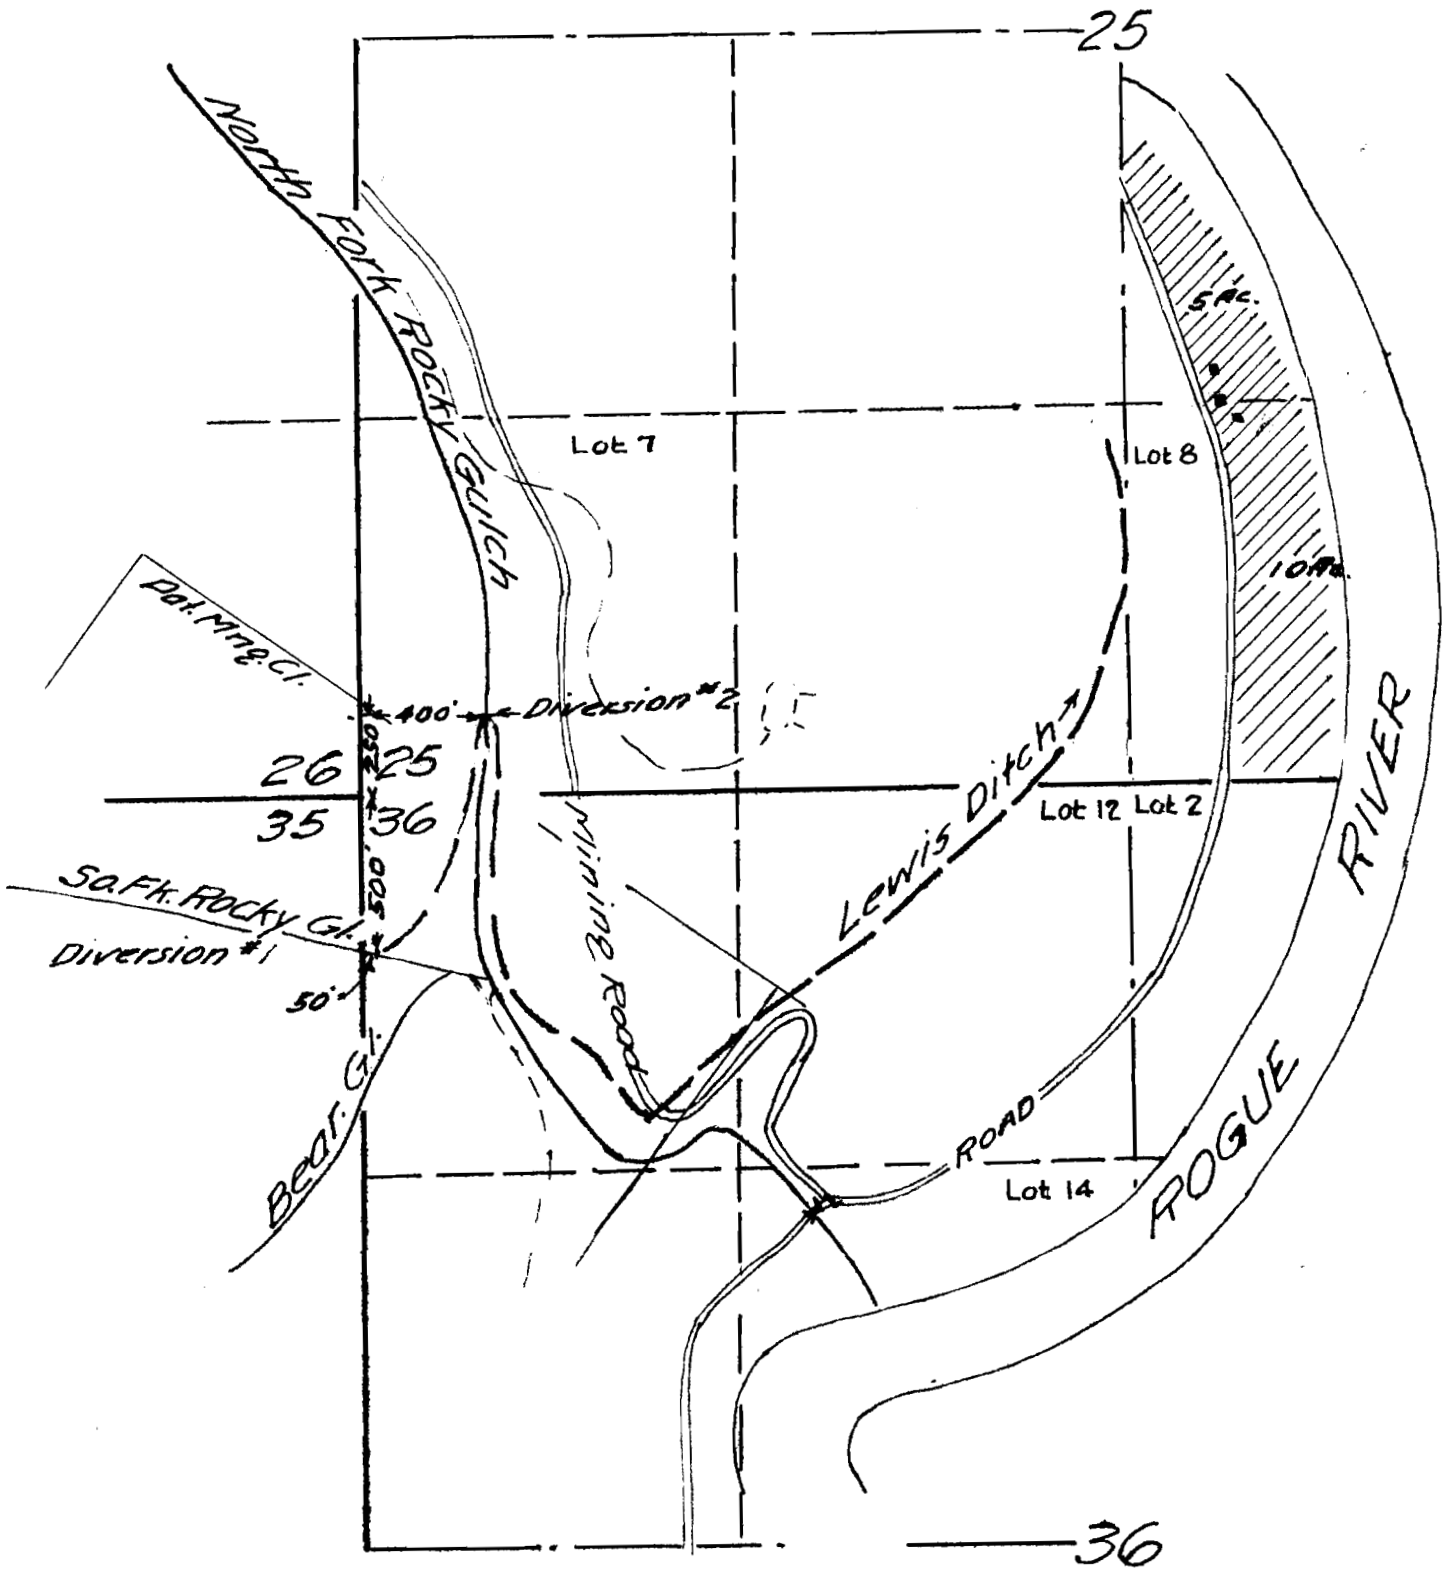

Estella M. Lewis

Application No. 22225

Permit No. 17198

Application No.

Permit No.