


SECTION

15

TOWNSHIP 35S, RANGE 4W, W. M.

North

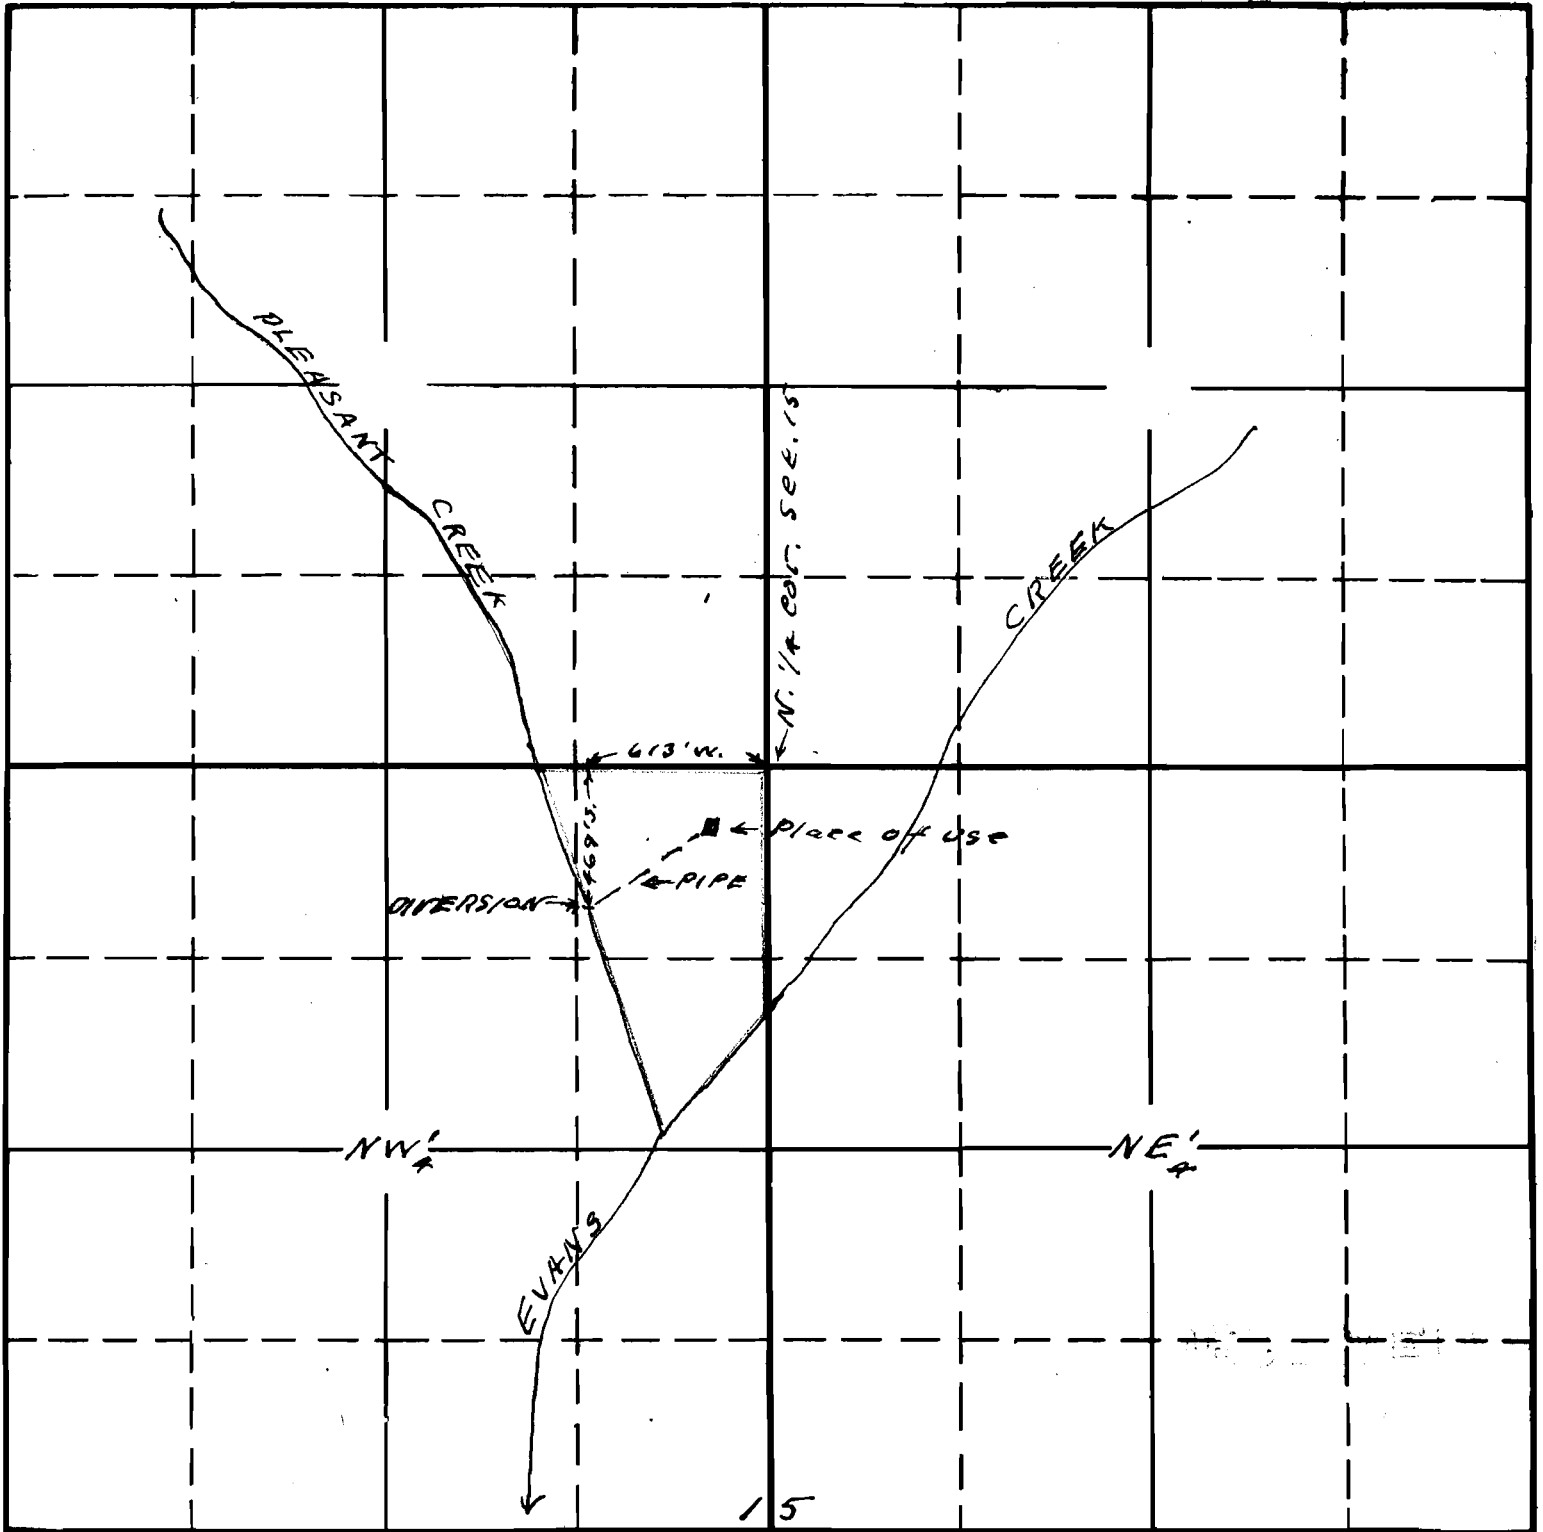

South

22224

42

Map to accompany application of
 L. E. Parcel for use of water from
 PLEASANT Creek for domestic and
 garden purposes

APPLICATION No. 22224
 PERMIT No. 17497

This office 1/4/47. *[Signature]*