


32

TOWNSHIP 34 S, RANGE 1 W, W. M.

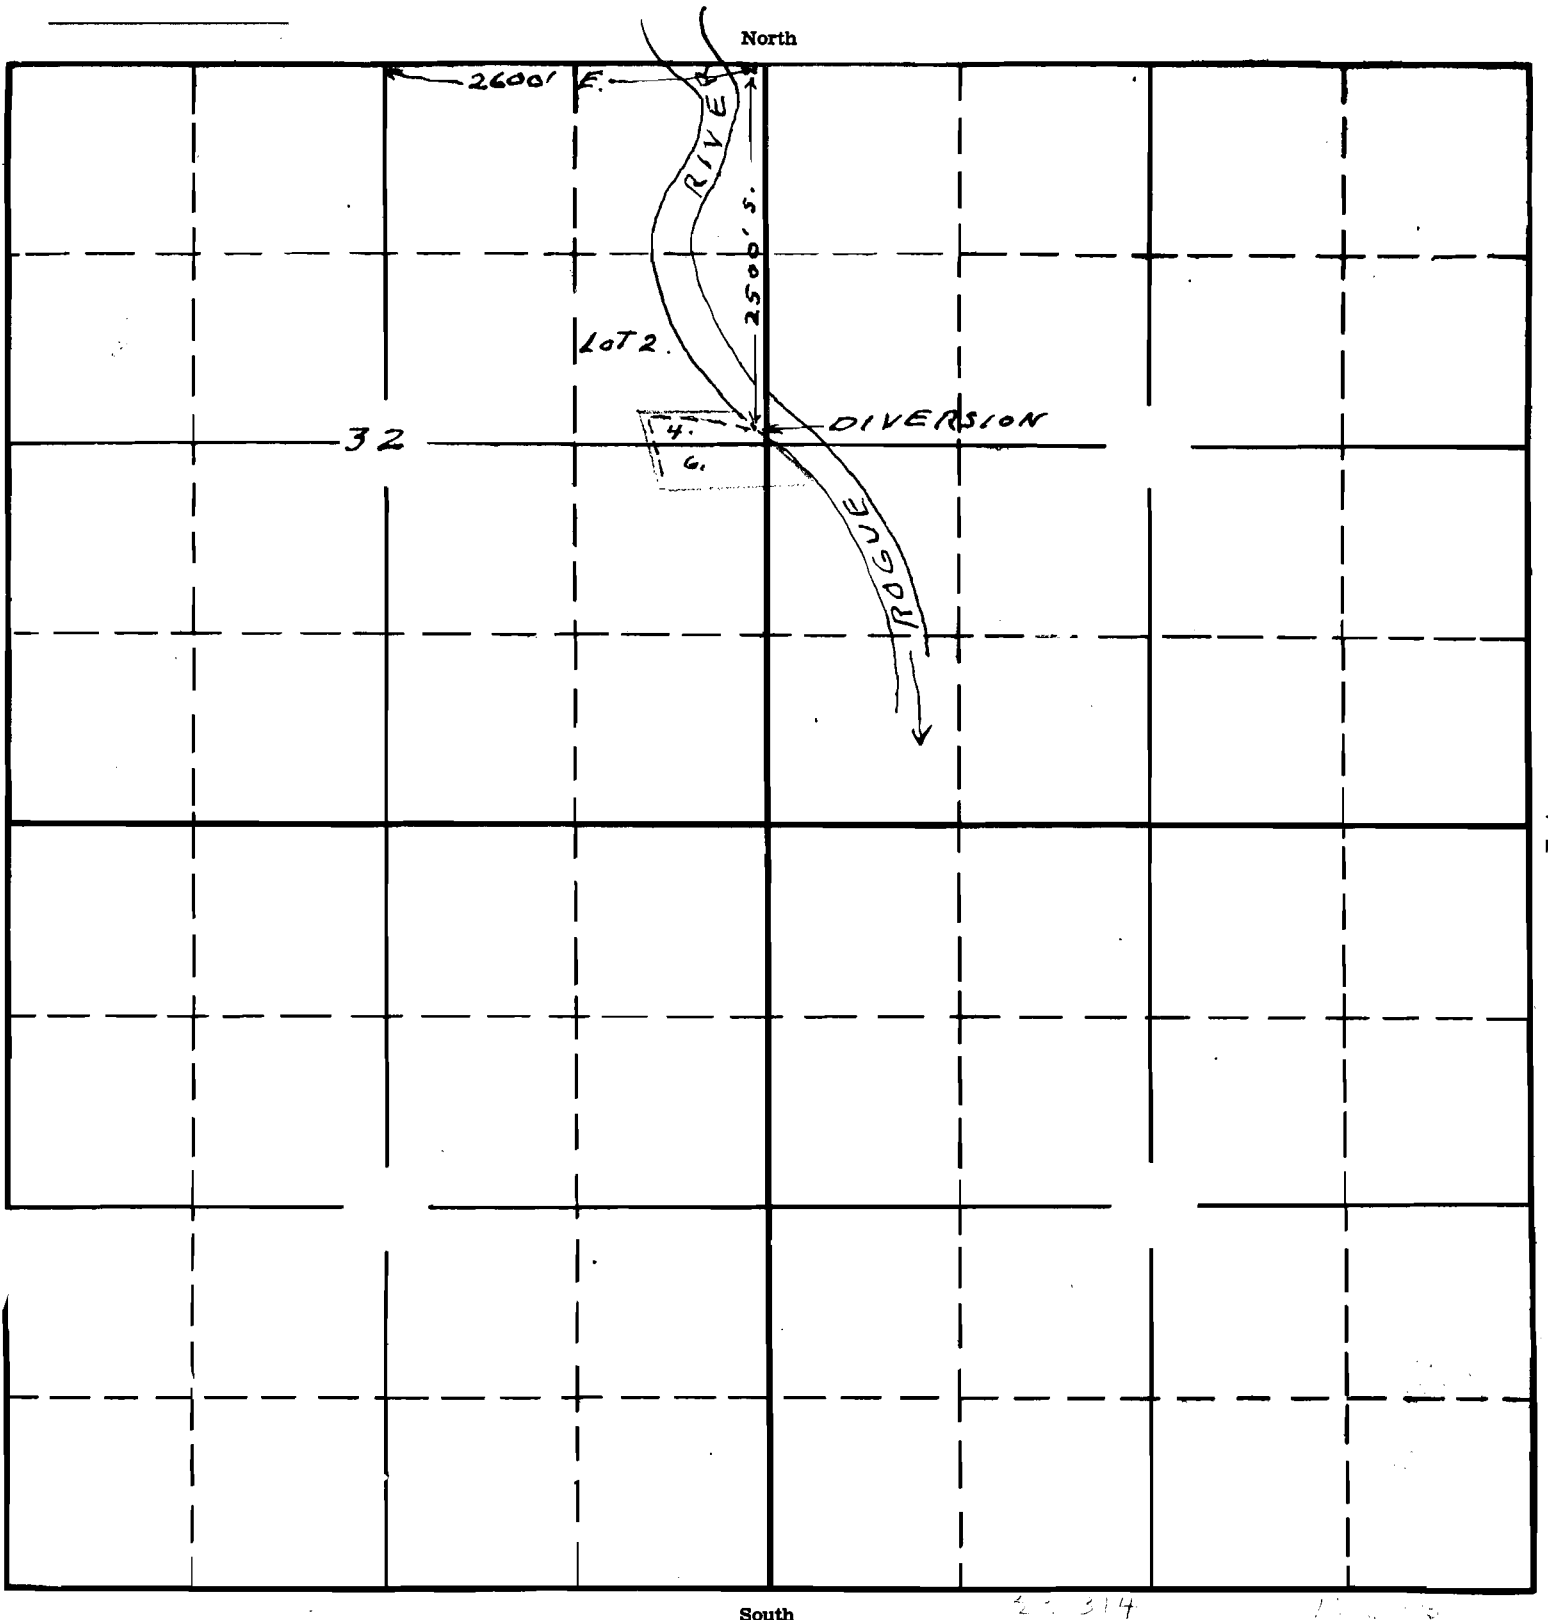

Map To accompany application of
 Mrs. Emma Marlette for use of water
 from Rogue River for irrigation.

APPLICATION No. 22314
 PERMIT No. 17550

This office 3/5/17 *Elmer*