


SECTION

TOWNSHIP 41 S, RANGE 8 W, W. M.

North

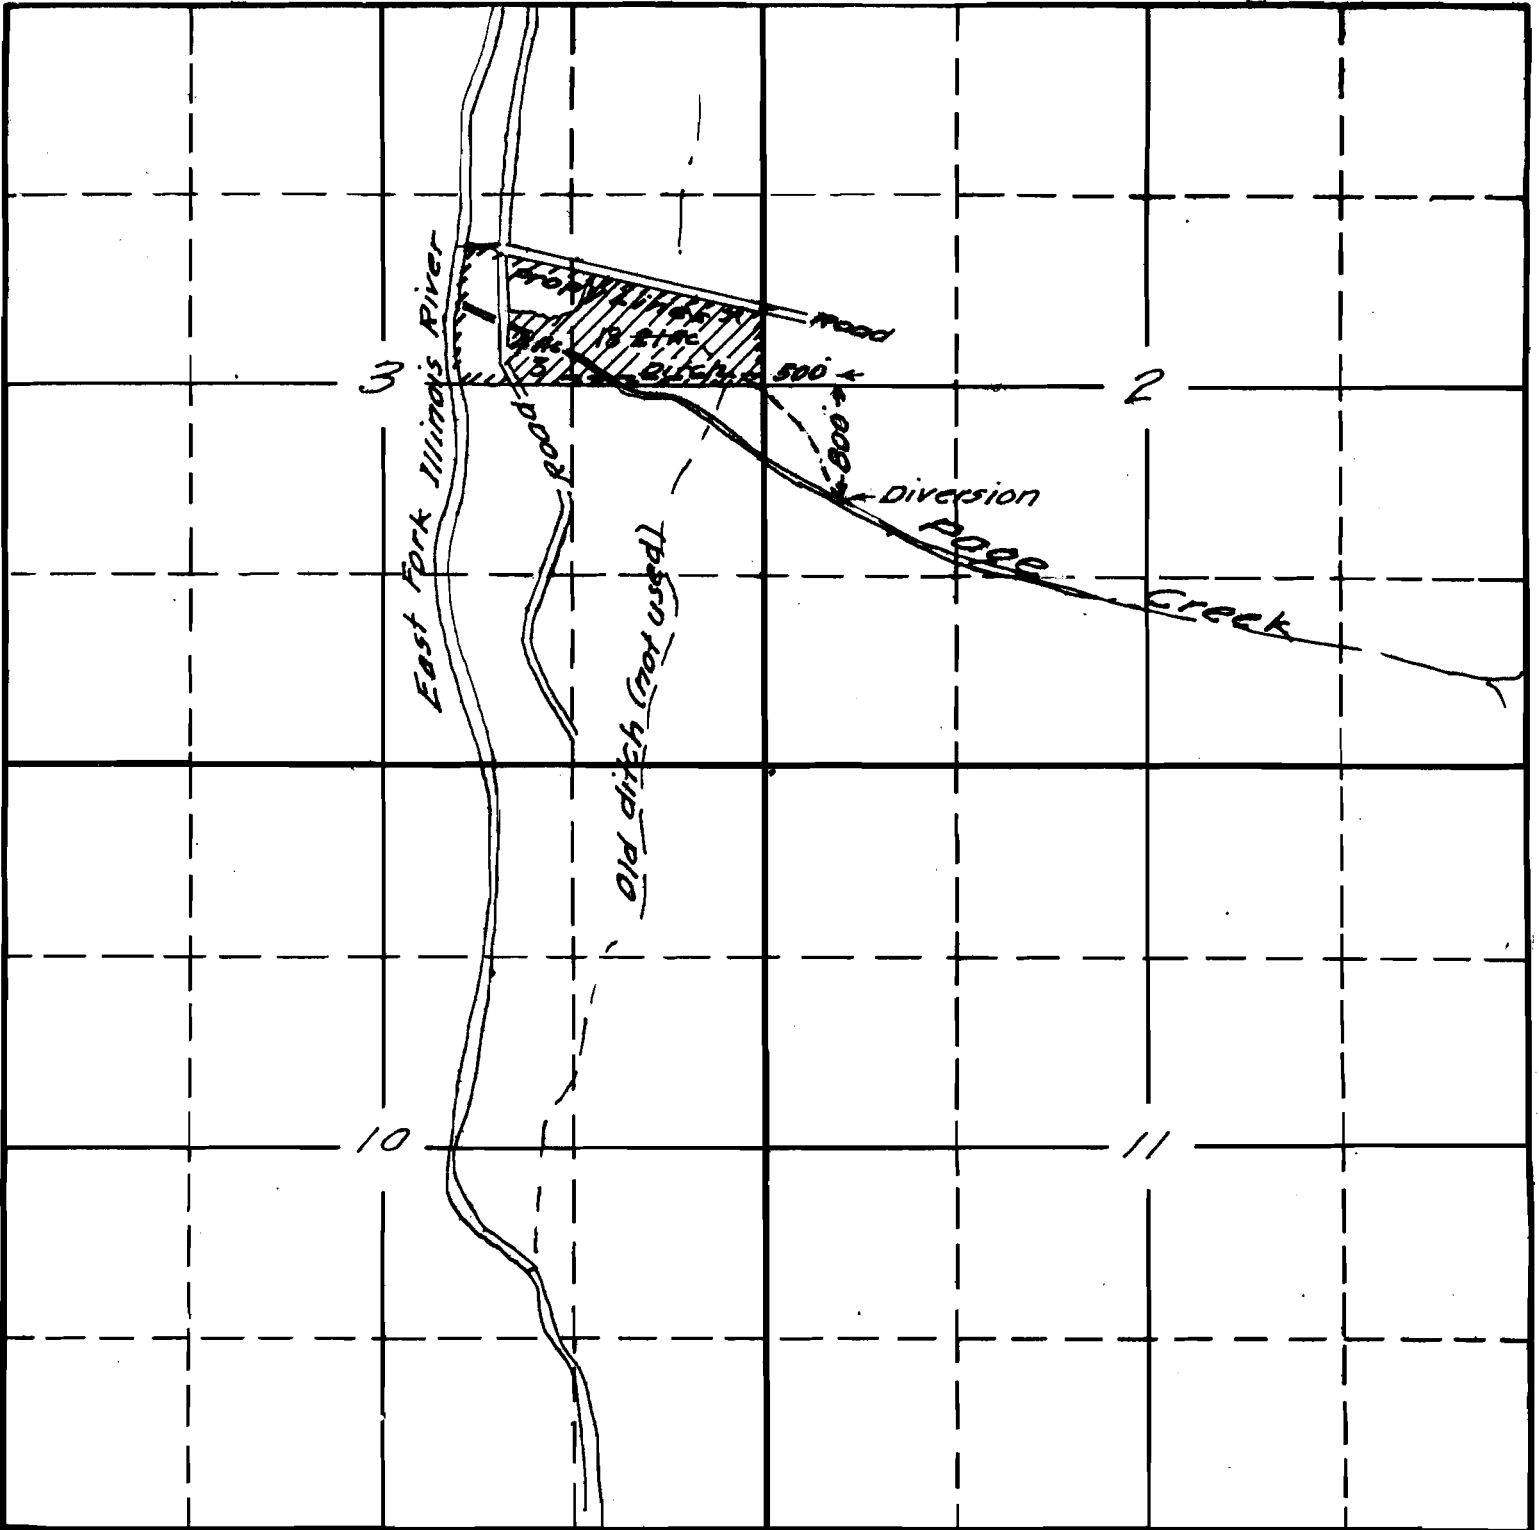

South

22418 15-560

Mark S. & Pauline R. Young
April 1947

RECEIVED

APPLICATION No. 22418

PERMIT No. 17670

STATE ENGINEER
SALEM OREGON