


T.41S.R.13W.W.M.

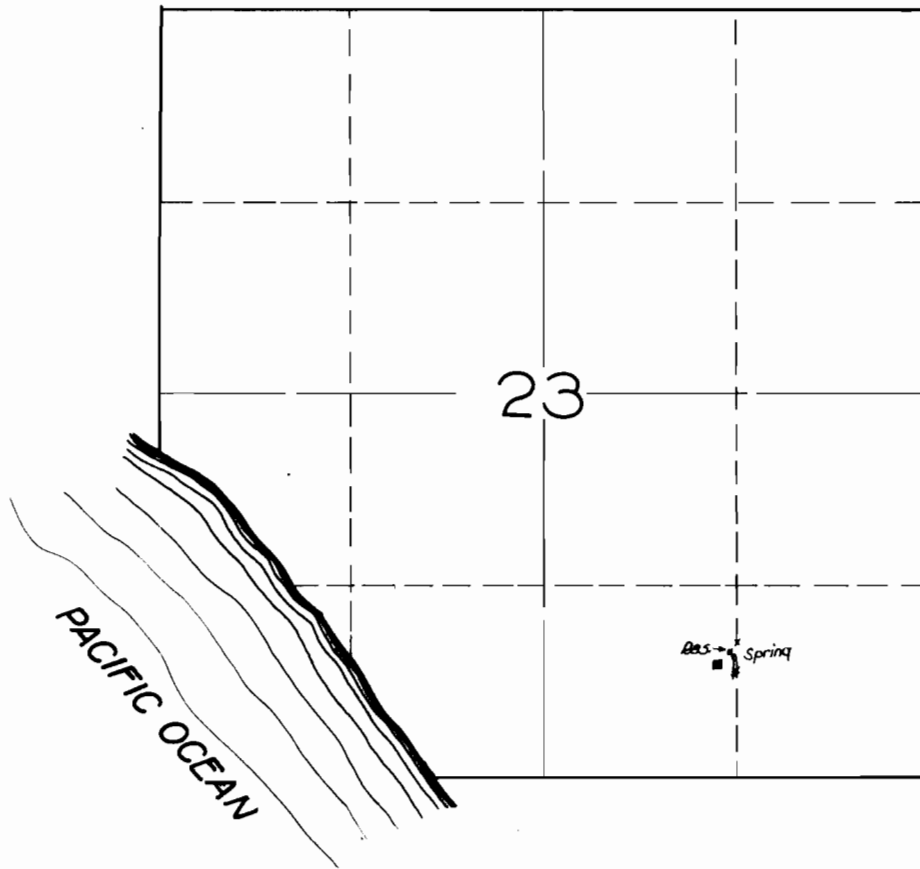

FINAL PROOF SURVEY

UNDER

Application No. *22910*... Permit No. *18063*
IN NAME OF

JAMES N. SHRADER & CORDIA B. SHRADER

Surveyed *AUG. 4*... 1949, by *HL. COFFMAN*