


# T.3S. R.1W.W.M.

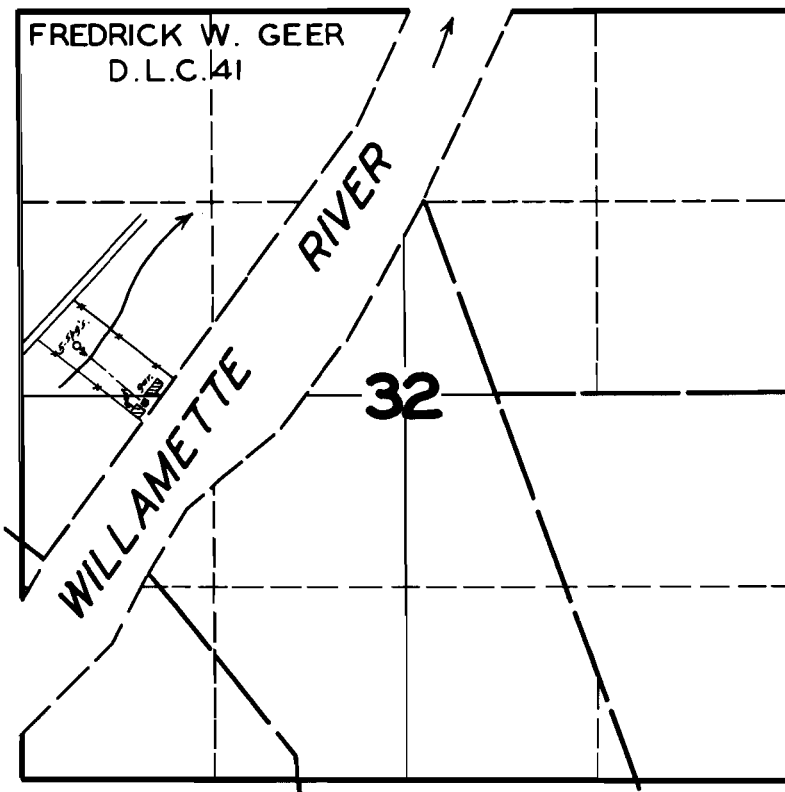

## FINAL PROOF SURVEY UNDER

Application No. 19500 Permit No. 15075

IN NAME OF

DR. GUY L. BOYDEN.

Surveyed MAY 5, 1945, by J. E. Hummel