


# T.24S.R.13W.W.M.

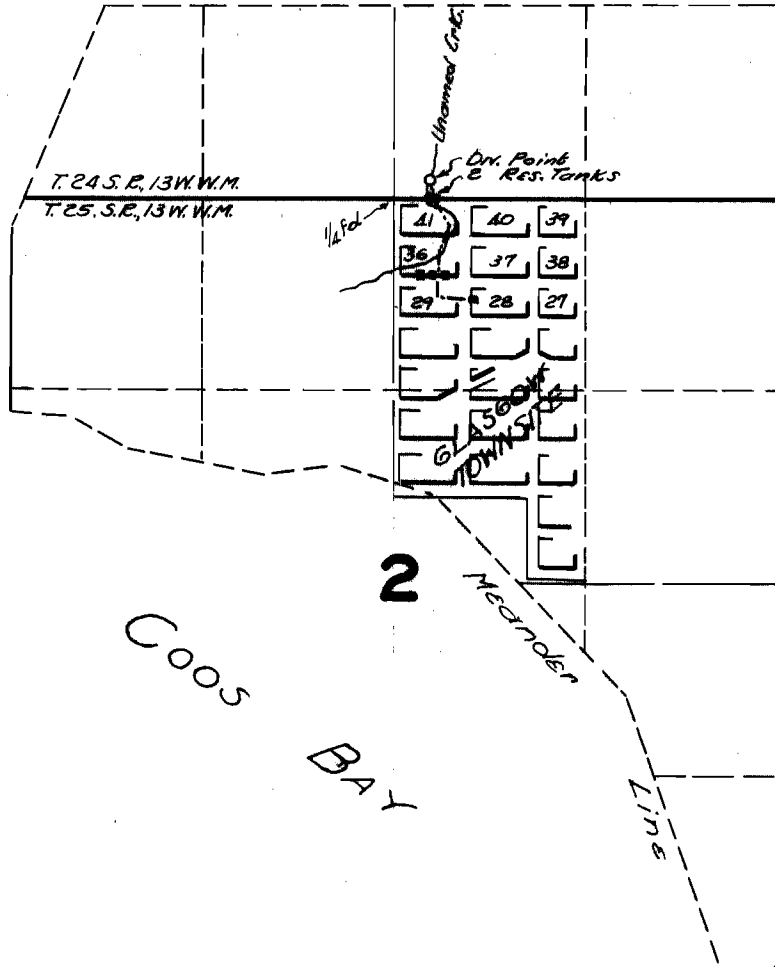

## FINAL PROOF SURVEY UNDER

Application No. 20841.. Permit No. 16313..  
IN NAME OF  
WILLIS R. SIMPSON, WALTER C. JOHNSON,  
BESSIE M. BROOKS & R.M. WHITE.....

Surveyed AUG. 22. 1949. by H.L. COFFMAN.