


T.24S.R.13W.W.M.

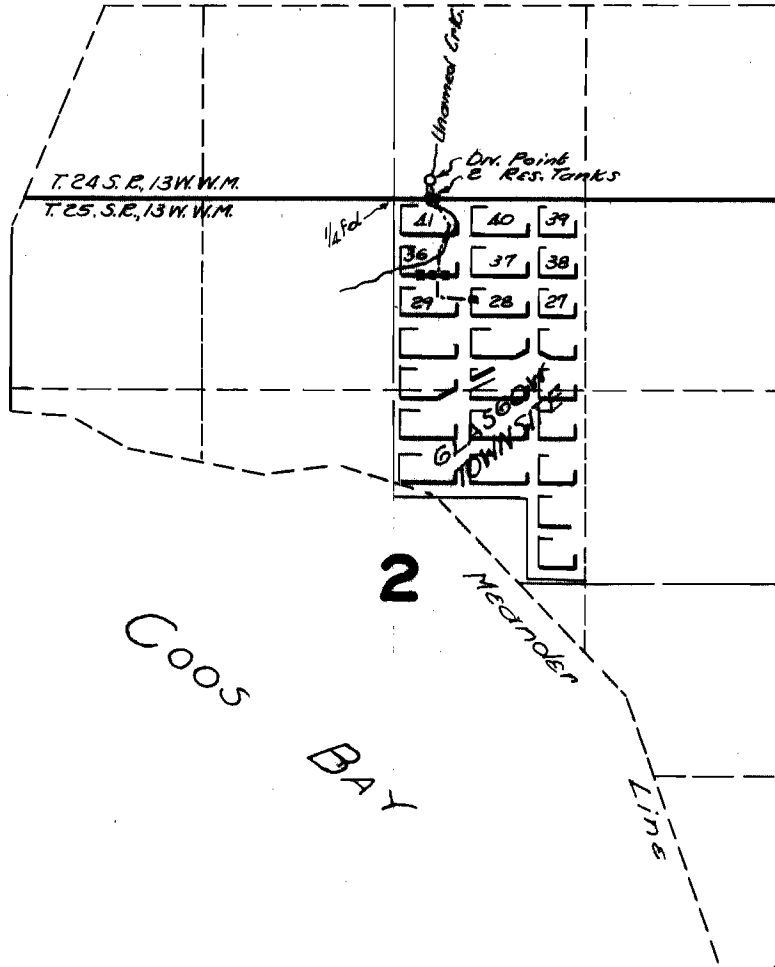

FINAL PROOF SURVEY UNDER

Application No. 20841.. Permit No. 16313..
IN NAME OF
WILLIS R. SIMPSON, WALTER C. JOHNSON,
BESSIE M. BROOKS & R.M. WHITE.....

Surveyed AUG. 22. 1949. by H.L. COFFMAN.