


Range 26 E.W.M.

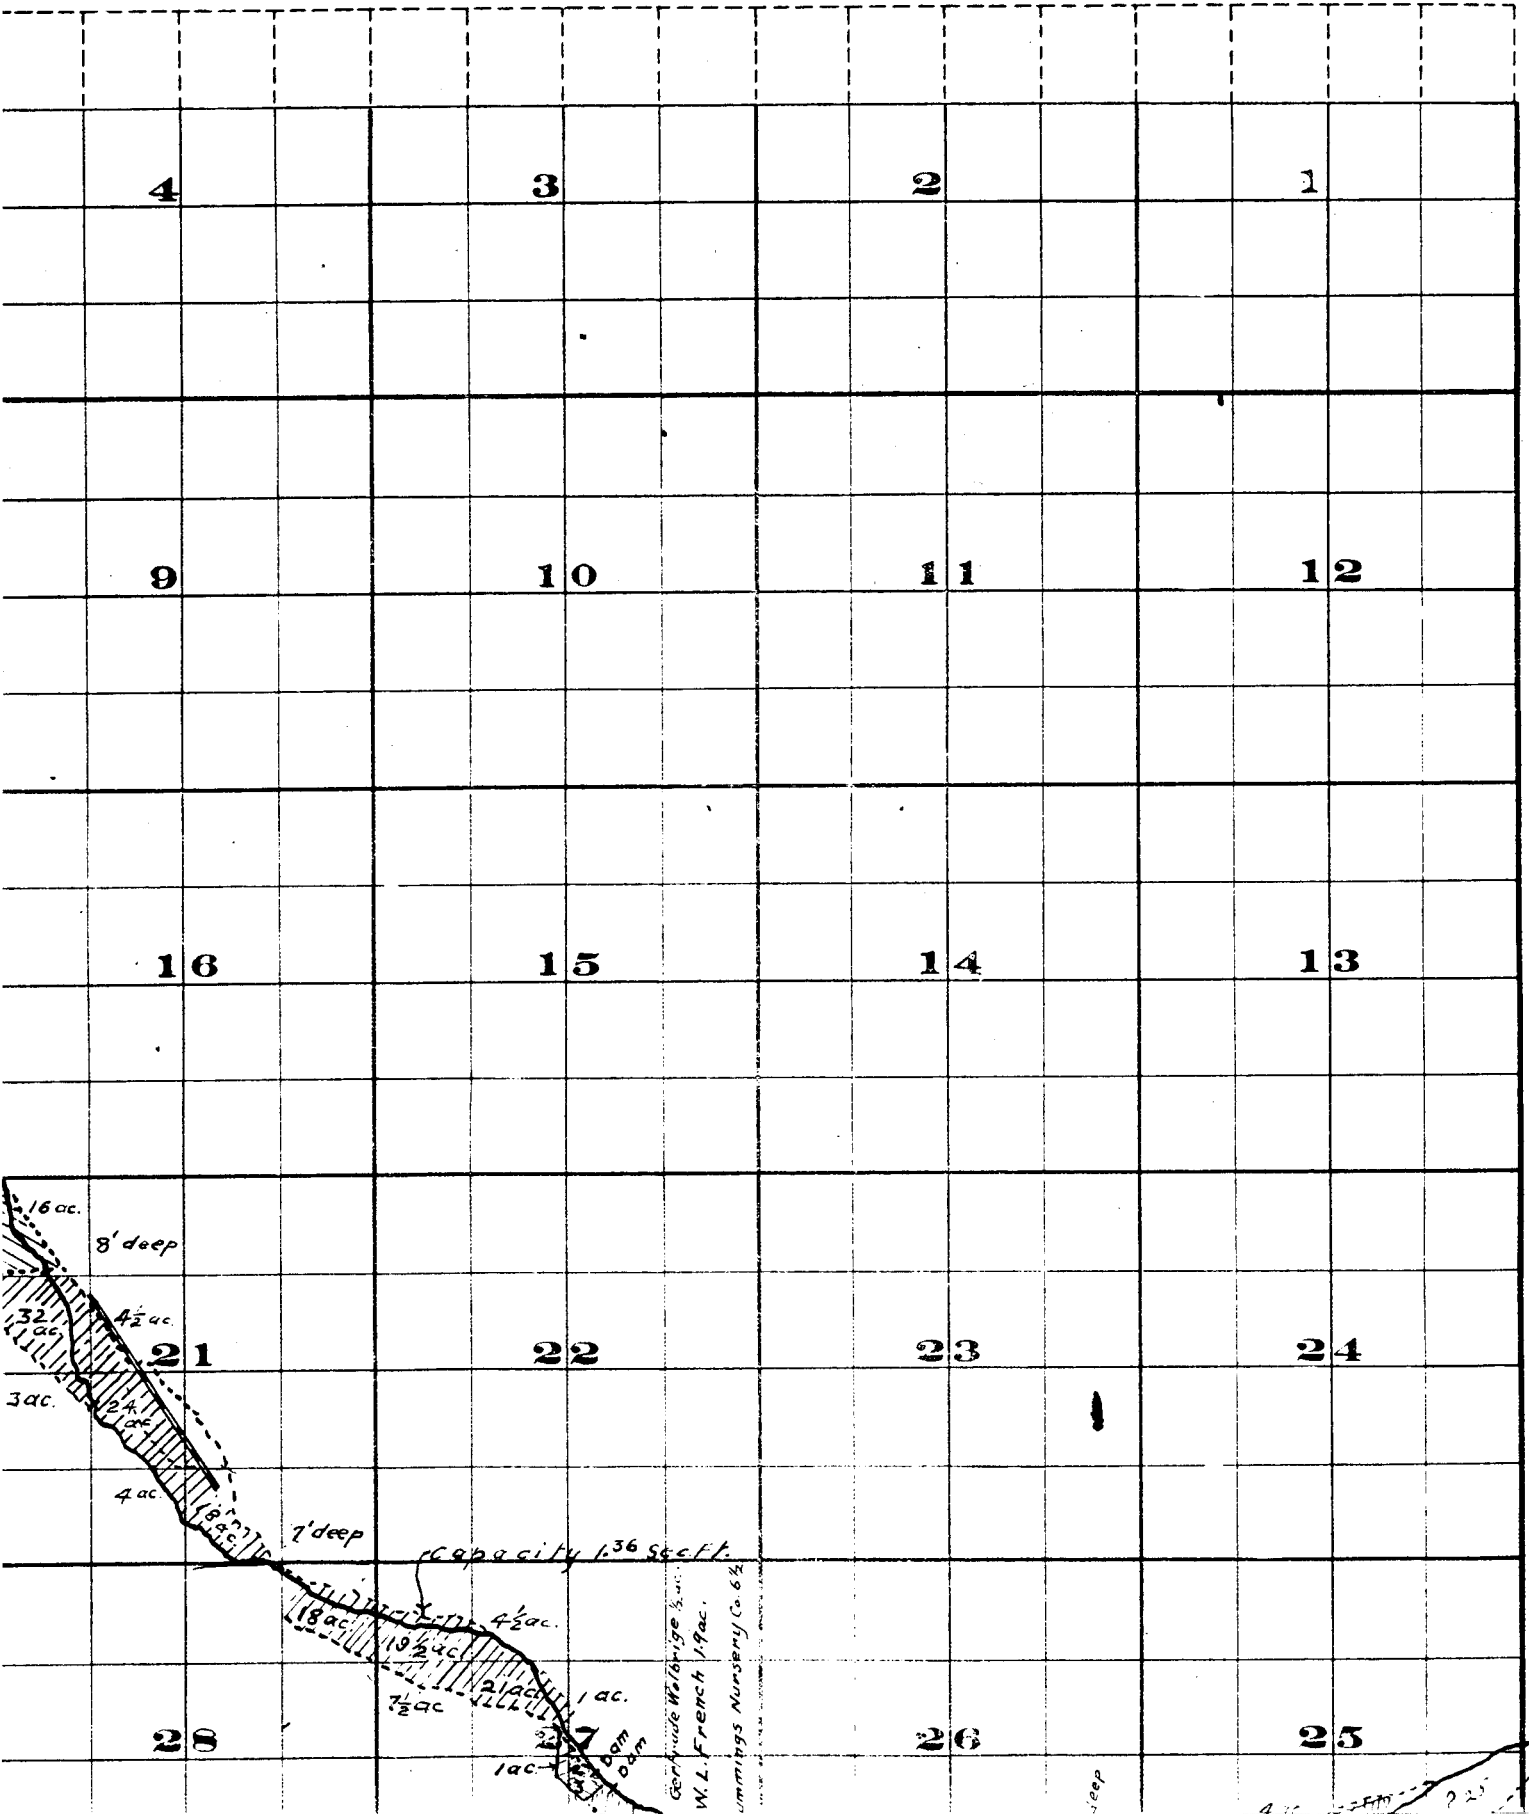

Township 2 S.

