


T. 35 S., R. 6 W

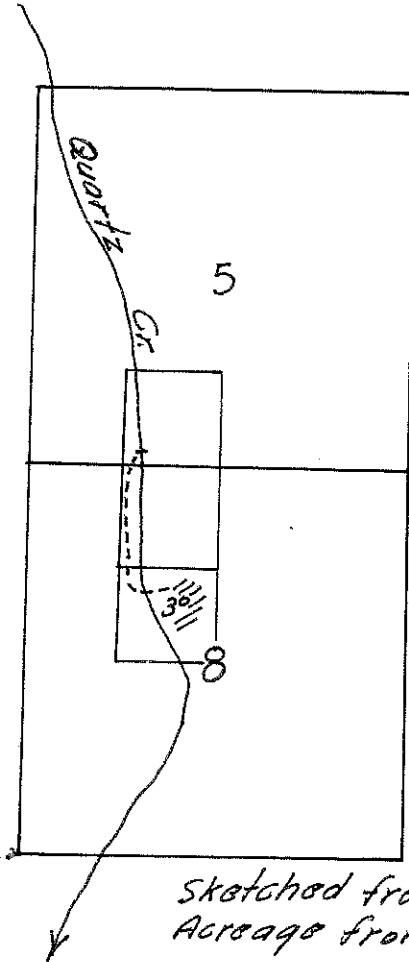

sketched from app. map.
Acreage from proof.

A-1759