


1492
50488
1803

T.10-II.S.R.34E.W.M.

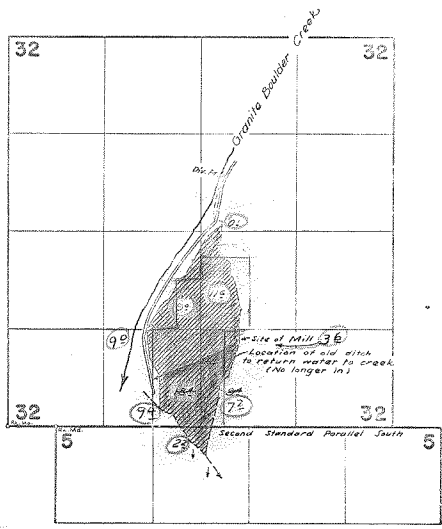

FINAL PROOF SURVEY UNDER

POWER CLAIM 270

Application No. 2794 Permit No. 1492
IN NAME OF

OXBOW RANCH

Surveyed August 23 1961, by L. Jackson