


Range 22 E.W.M.

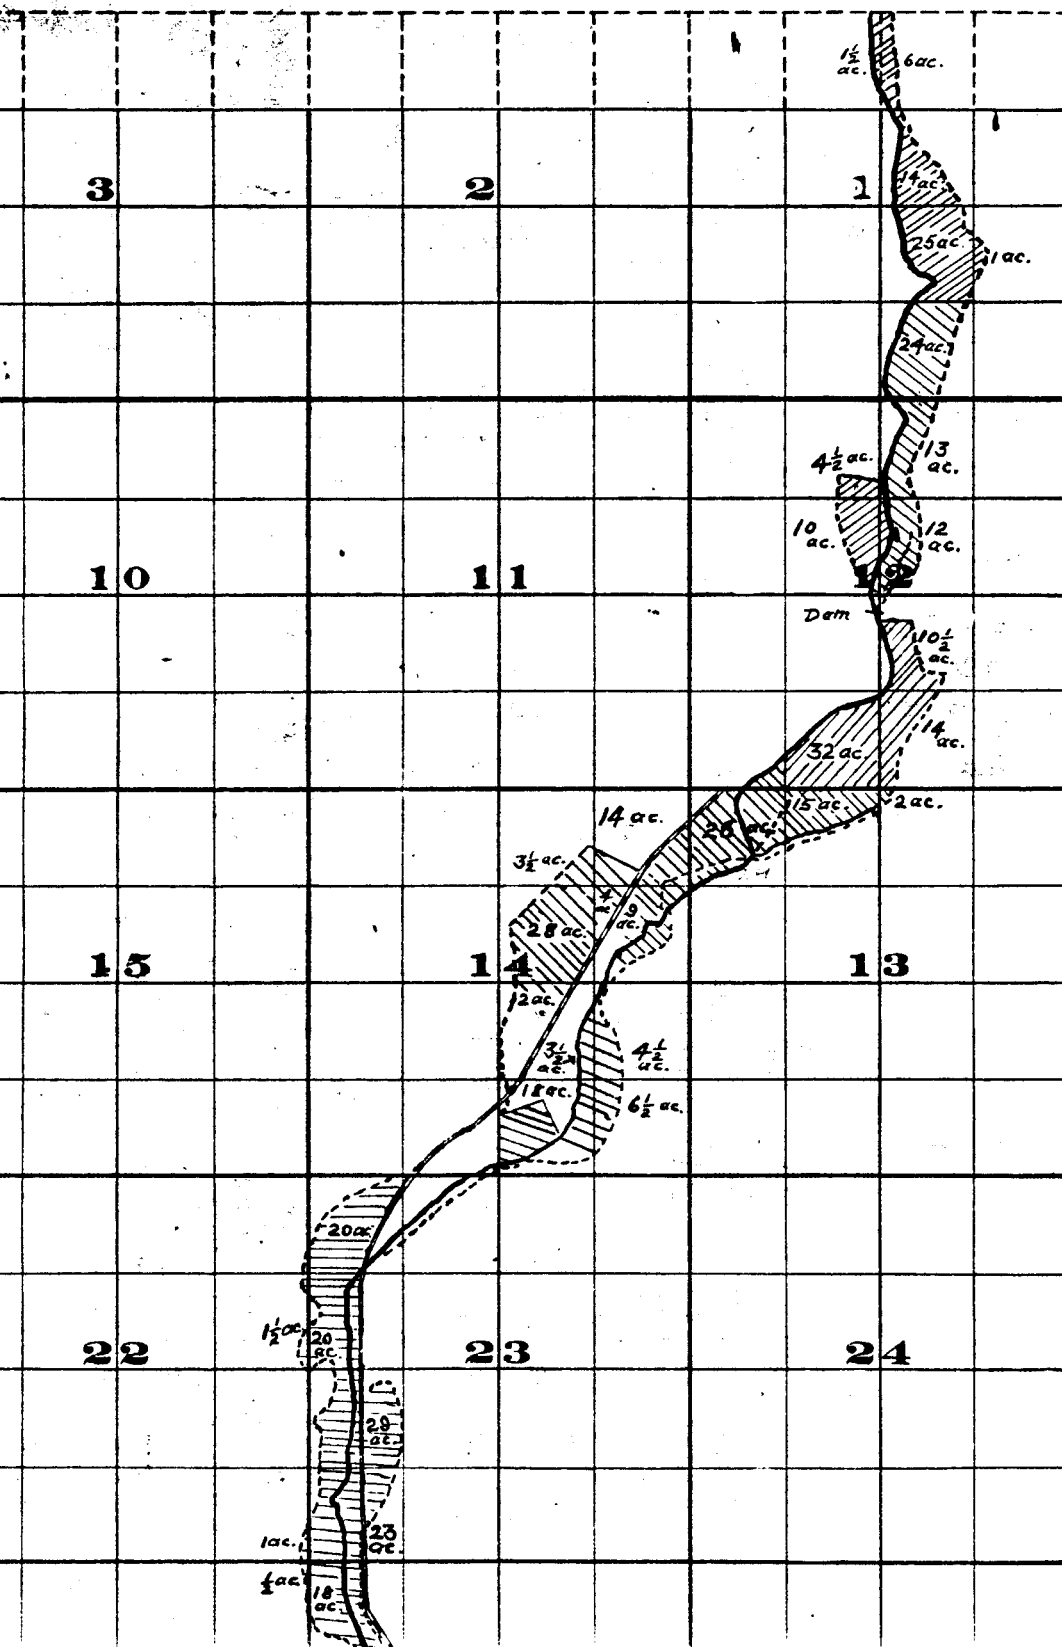


	18			17				16				15	
	19			20				21				22	
	30			29				28				27	
	31			32				33				34	

THE S. A. BRISTOL CO., PRINTERS & BOOKBINDERS, CHEYENNE, WYO

Surveyed by H. H. Donnelly July 1909

John H. Lewis - State Engineer

Examined - July 14, 1909

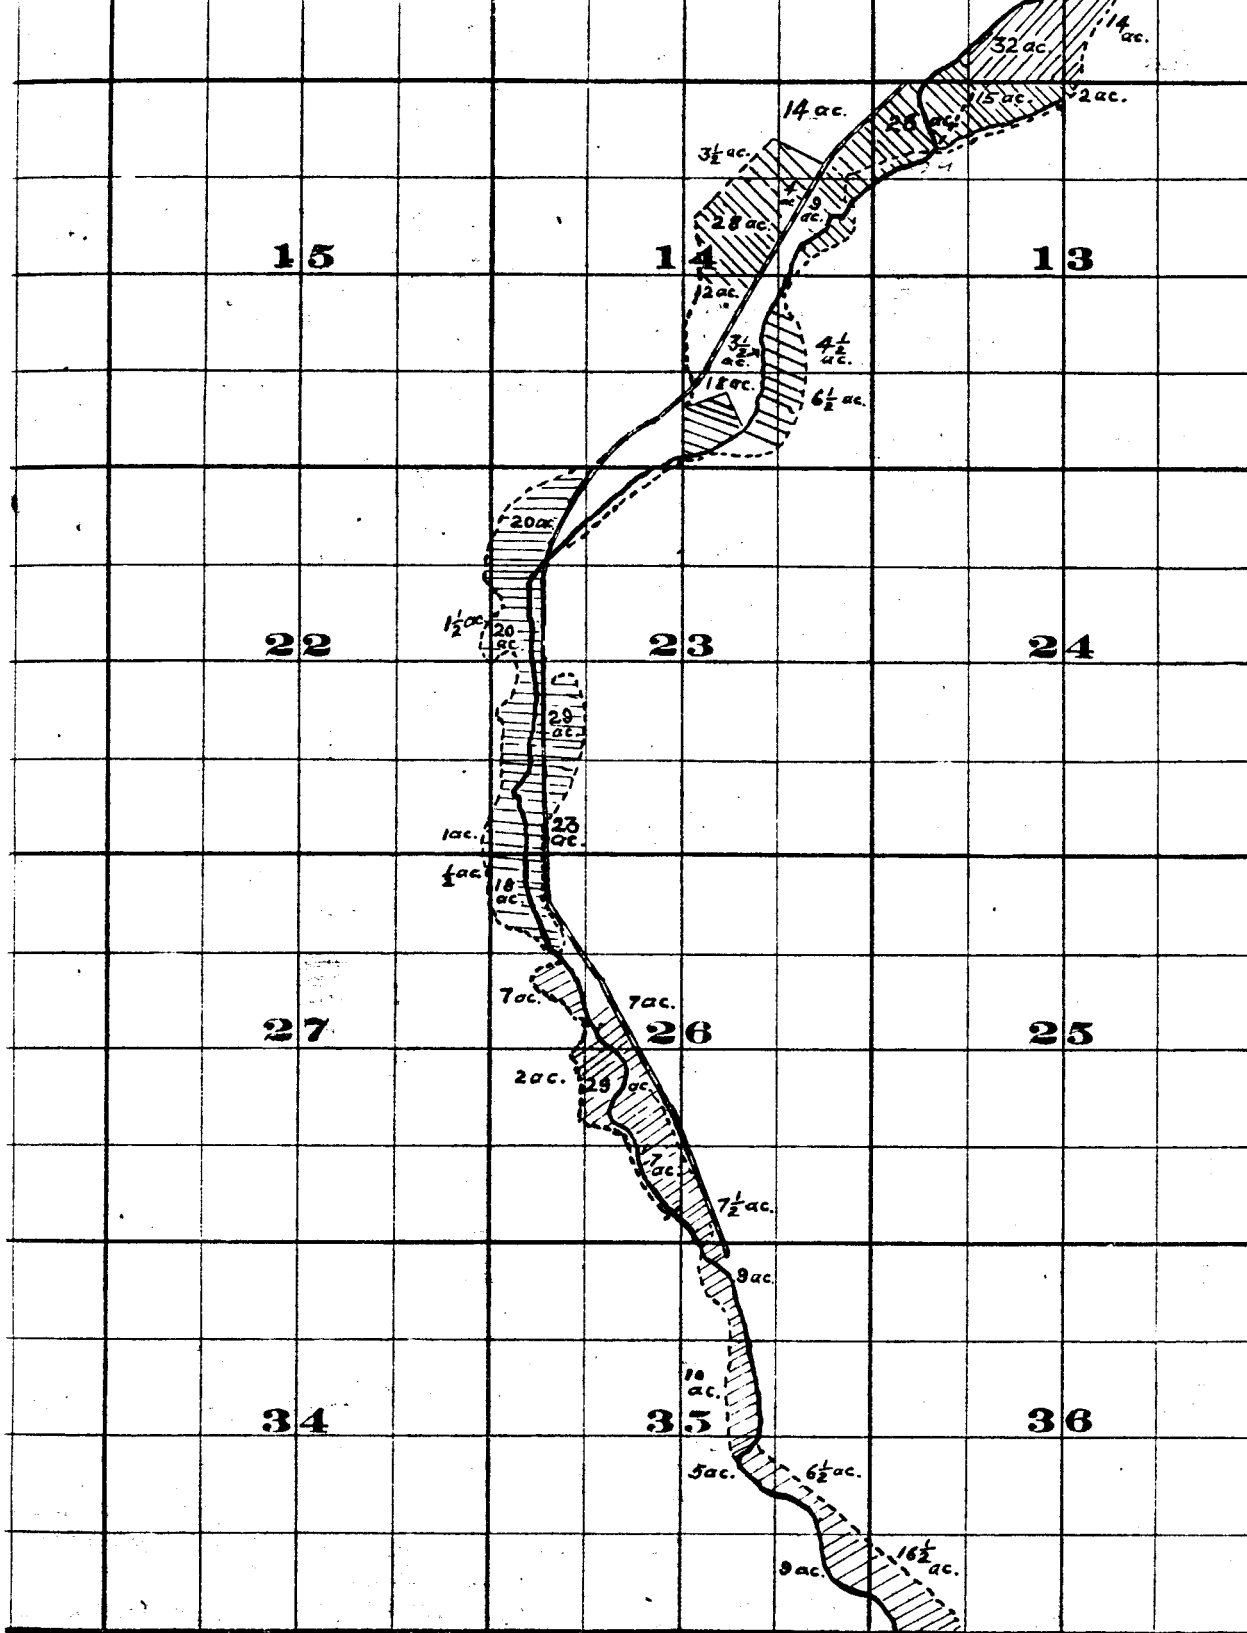

FROM OFFICE OF THE STATE ENGINEER, SALEM, OREGON

Willow Creek Adjudication.

3 N. 2 E.