

174
Map of 300

ACREAGE
270.6 (ACTUAL CANTON)
418.2 (MATH. ADJUST)
476.8 (270.6 + 206.2)
Ditto

MAP of

BRENT DITCH

SCALE

50 FEET = 1 MILE


CERTIFICATE OF SURVEYOR

I, *Vernon L. Glaze* of *John Day, Oregon* do hereby certify that this map was made from notes taken during an actual survey made by me on *March 6, 1914* and that it correctly represents the works described in the accompanying application, together with the location of streams in the immediate vicinity.

Vernon L. Glaze
Surveyor

OFFICE OF STATE ENGINEER
RECEIVED
MAY 10 1915
OREGON

Application No. *4150*
Platting No. *2387*

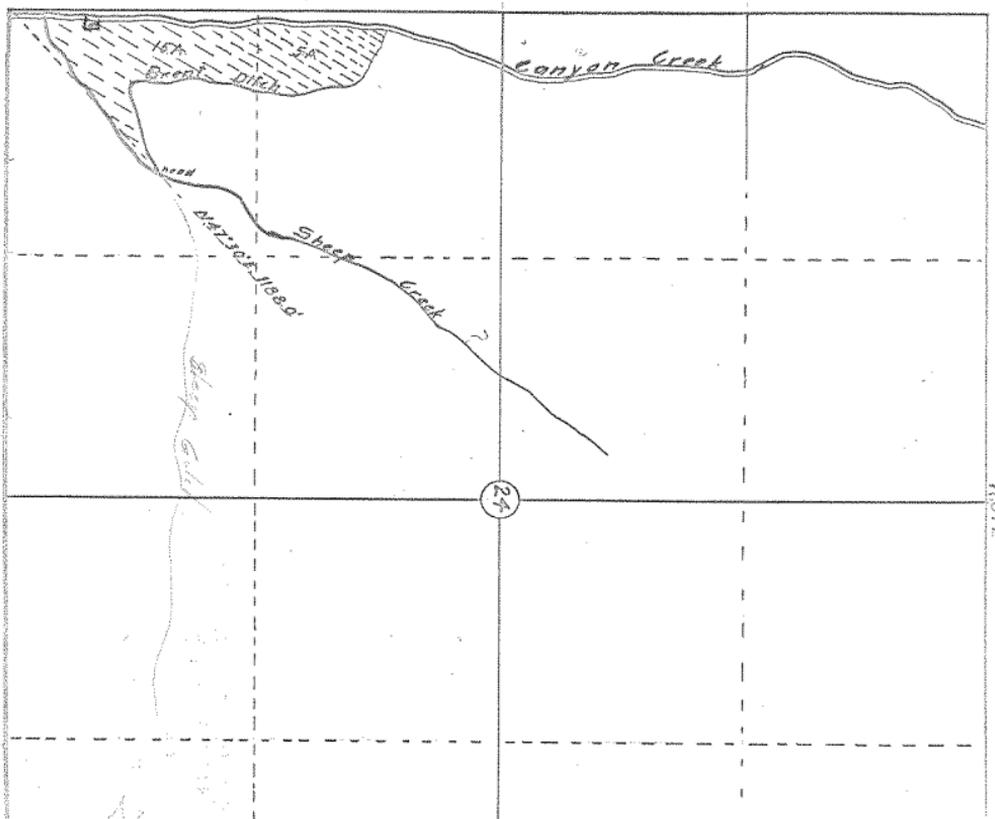

ROLE