


T. 1 S. R. 9 W. W. M.

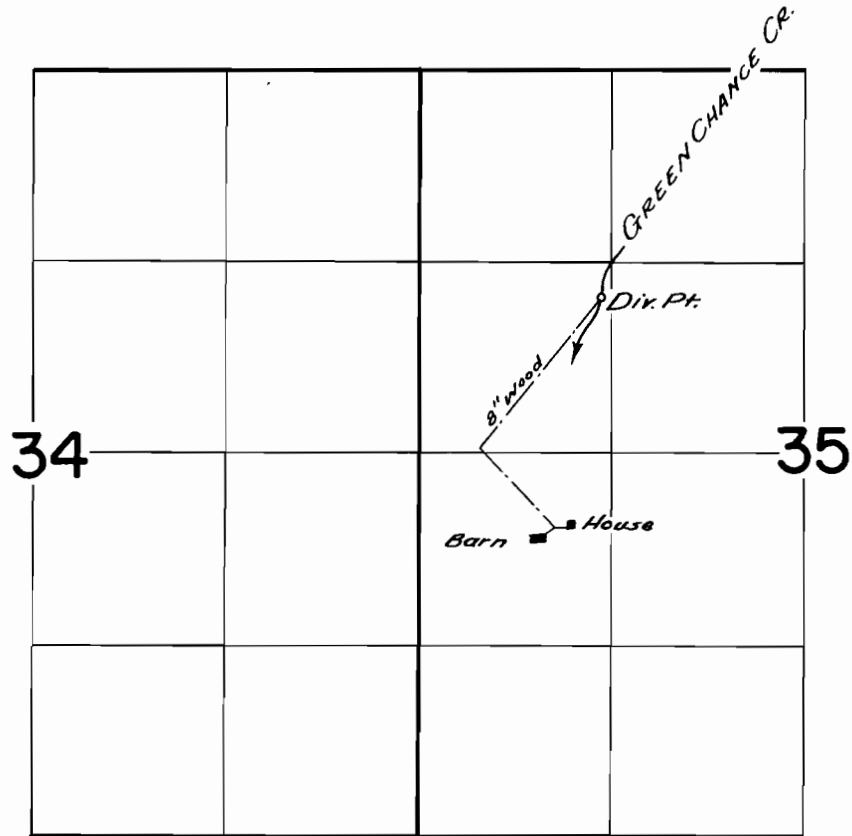

FINAL PROOF SURVEY UNDER

Power Claim # 341
Application No. 3978... Permit No. 2272...
IN NAME OF

..... *Peter Zirr*

Surveyed *June 28 1961*, by *COBARTOLO*