

FROM OFFICE OF THE STATE ENGINEER, SALEM, OREGON

*Willow Creek Adjudication.*

15.24E

P. 1. 35

18

17

16

15

19

20

21

22

30

29

28

27

31

32

33


34

Surveyed by A.D. Cooper July 1909

John H. Lewis - State Engineer

Examined July 14, 1909.

# Township 15. ,

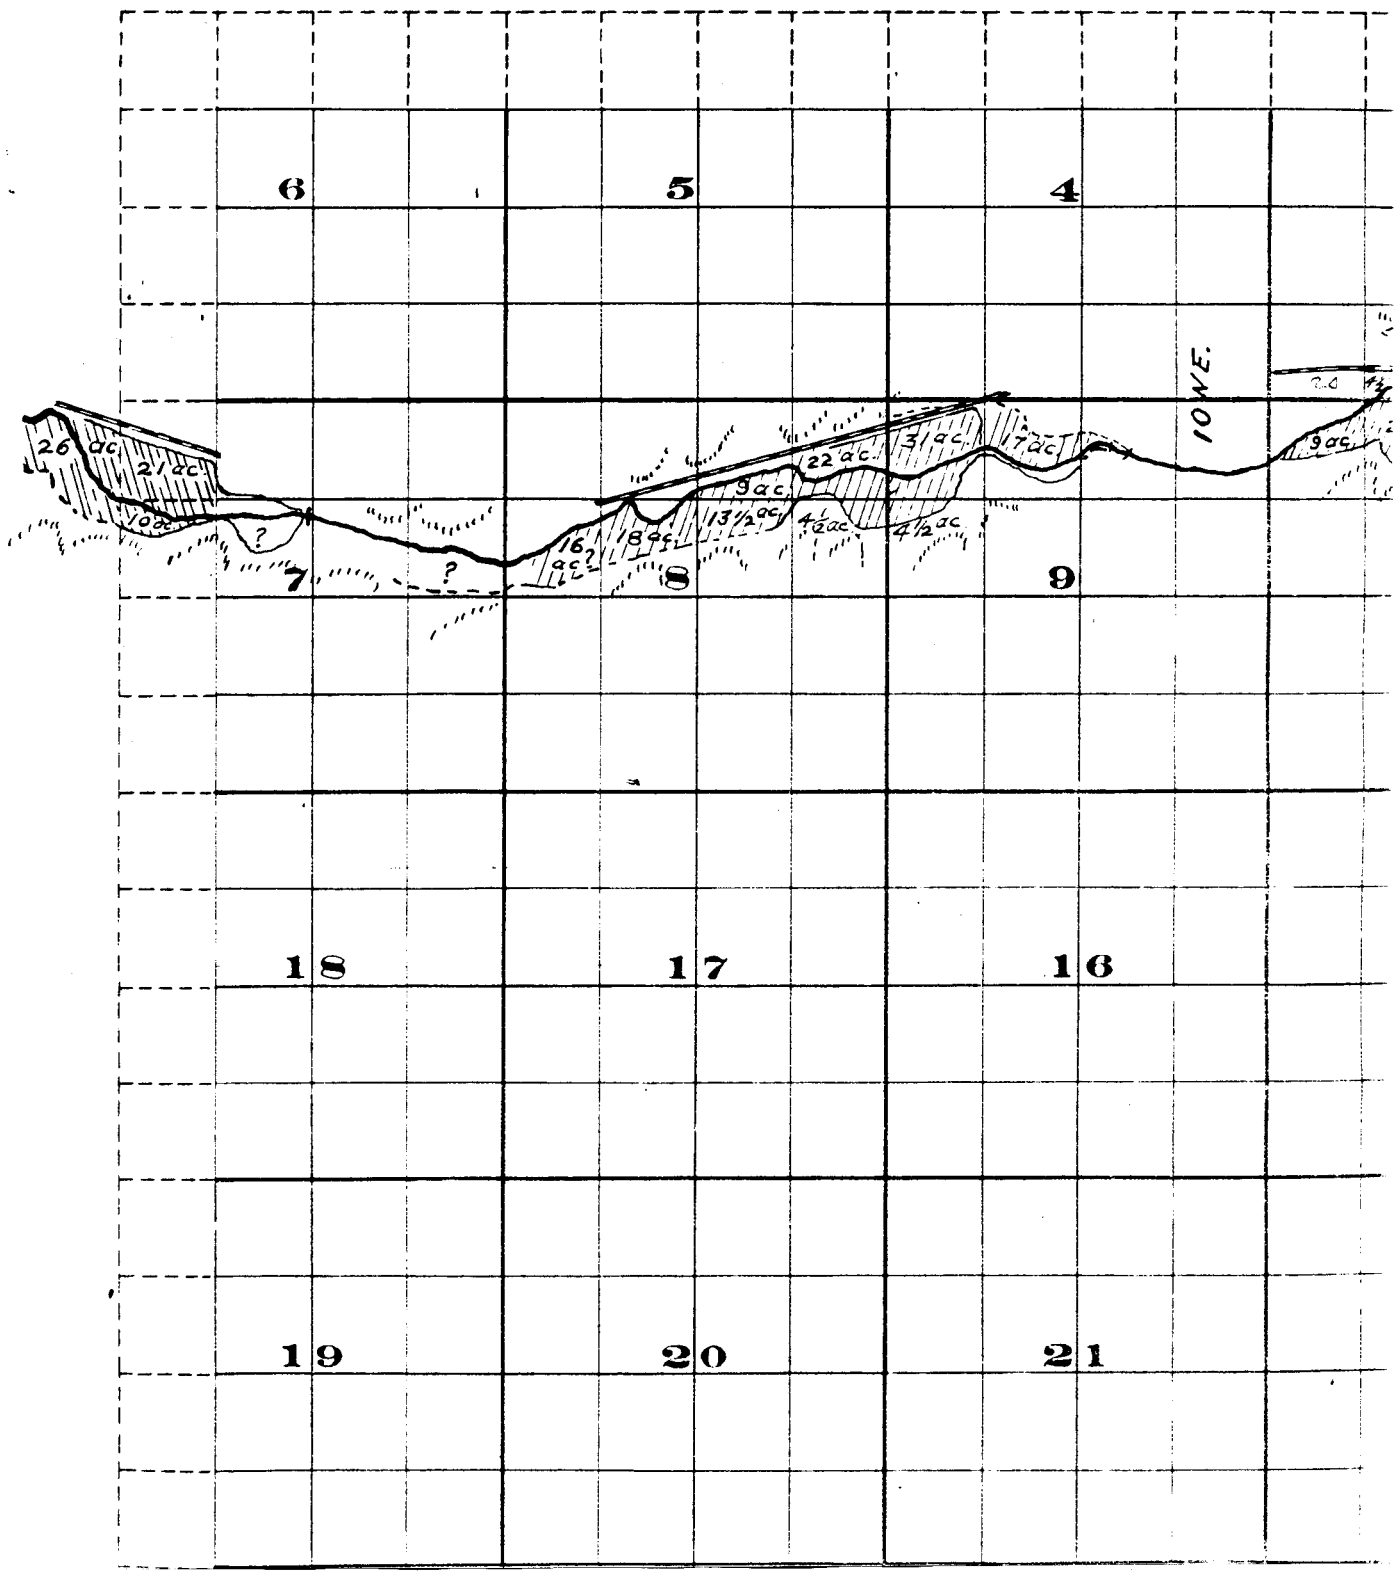

# Range 24 E.W.M.

