

505
1863



T. 39 S R. 12 E

18 17 16

19 20 21

30 29 28

31 32 33

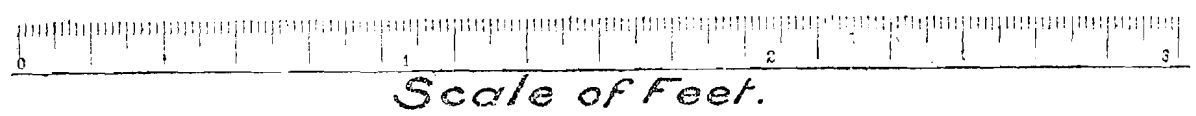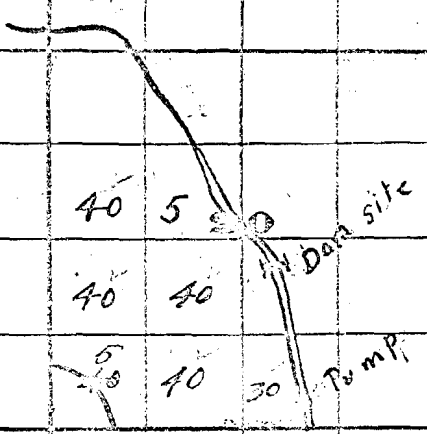

Application No. 1070
Permit No. 505

East River