


197X

FAULKNER DITCH

OFFICE OF STATE ENGINEER
RECEIVED
MAR 14 1910
SALEM, OREGON.

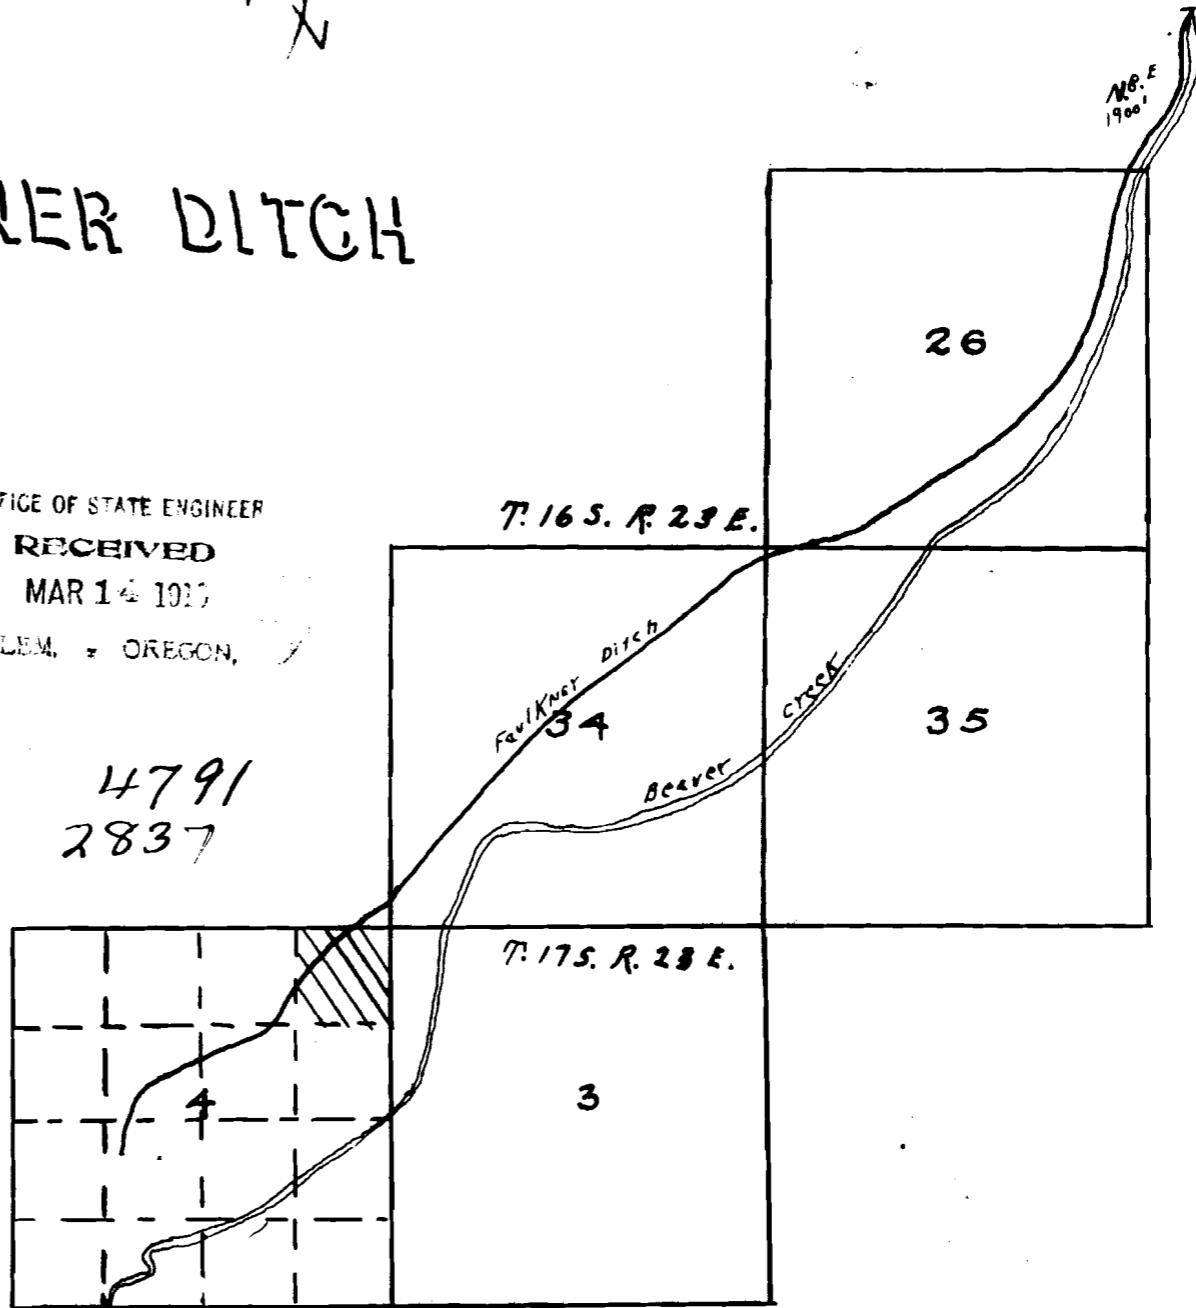

4791
2837

2837

197X

H.G.K.

1901