

1906

X  
10  
Z

# THROOP DITCH


OFFICE OF STATE ENGINEER

~~RECORDED~~

MAY 15 1918

SALEM, OREGON,

Application No. 4914  
Permit No. 2933

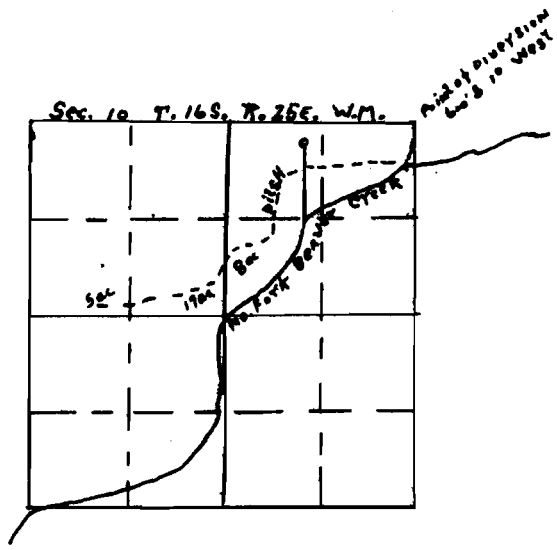

X 1918