

T. S. S. R. 15. E.


Antelope creek.

Temporary dam  
replaced each spring.

Creek divides  
leaving small irrigable  
island between (about 2 1/2 A.)  
Tehant

Sec. 33.

Wames Co.  
Jefferson Co.

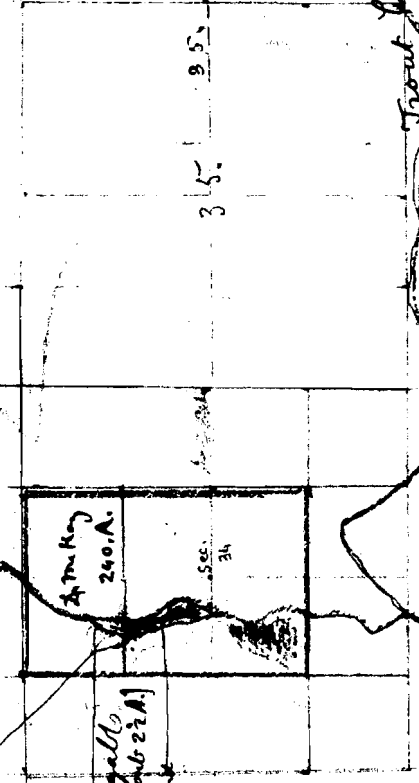

Application No. 5257  
Permit No. 3190

OF STATE ENGINEER  
RECEIVED  
C-13 1913  
OREGON

H. L. Rooper

Surveyed Oct 12<sup>th</sup> 1913.

3190