




# Range 26 E. W. M.

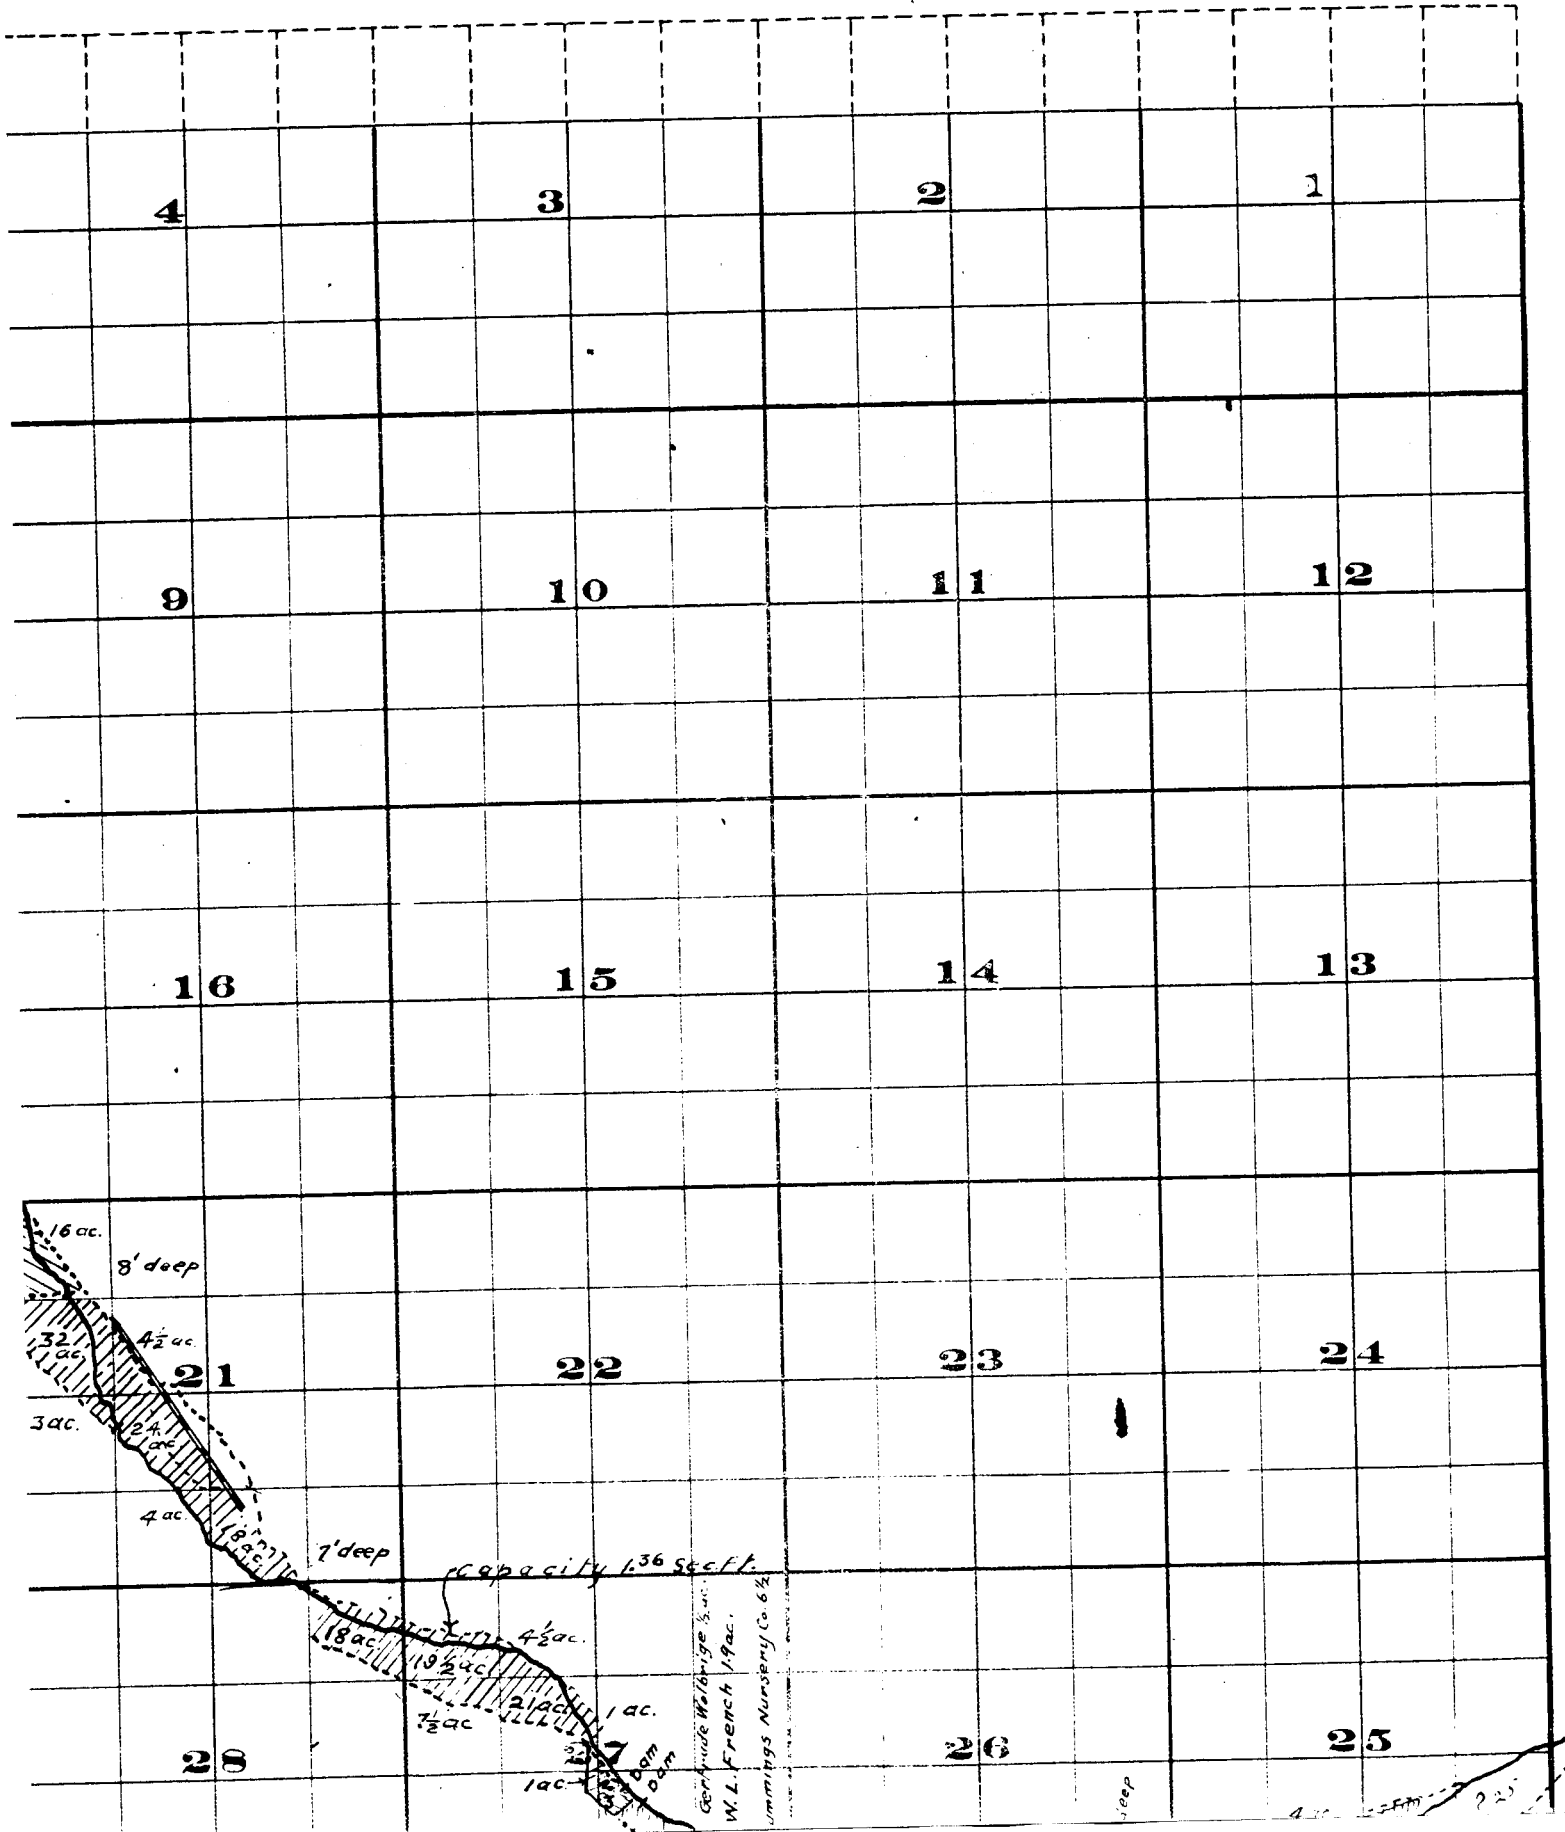

# Township 2 S. ,

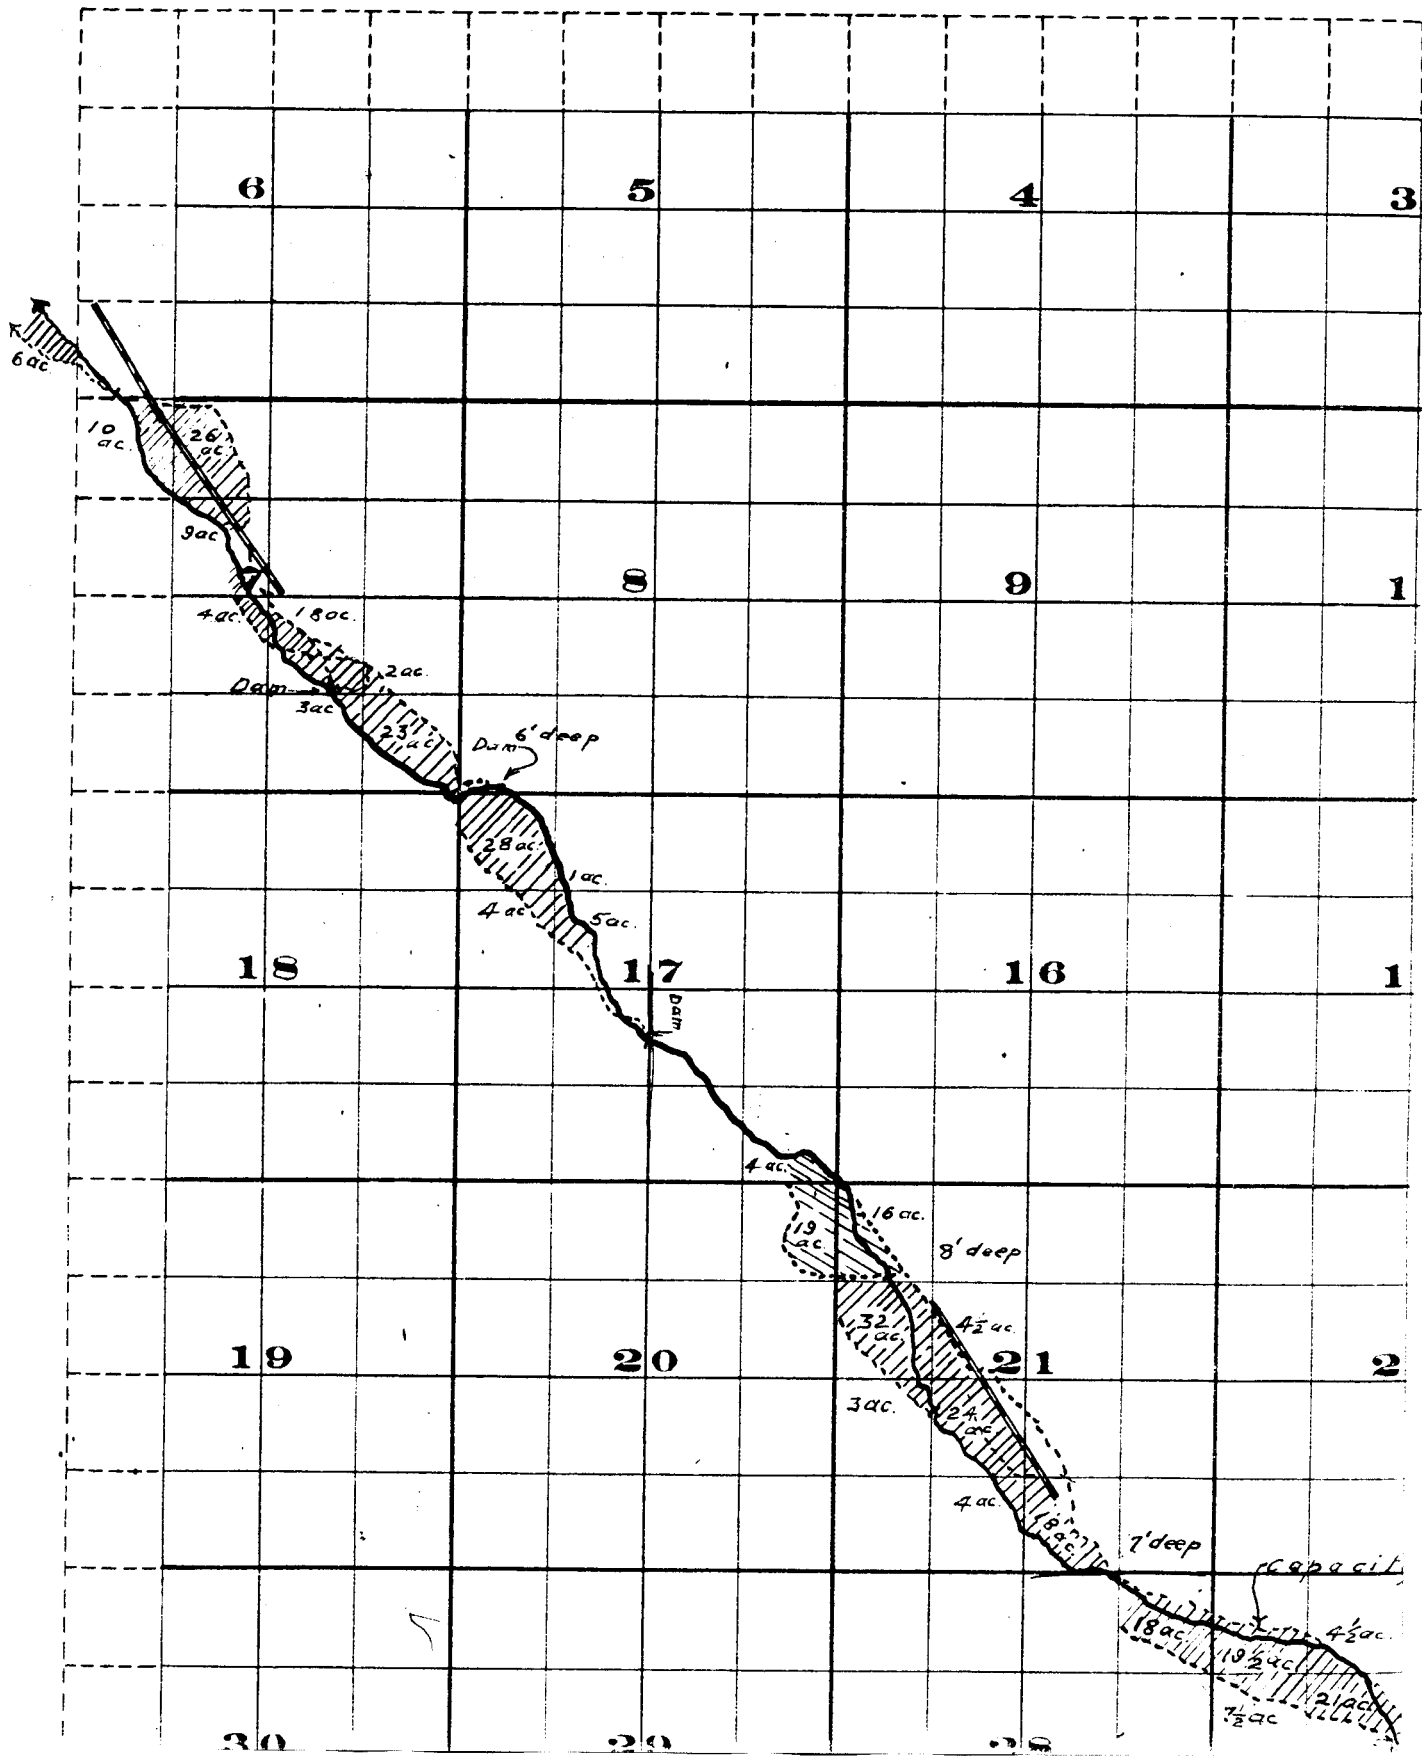

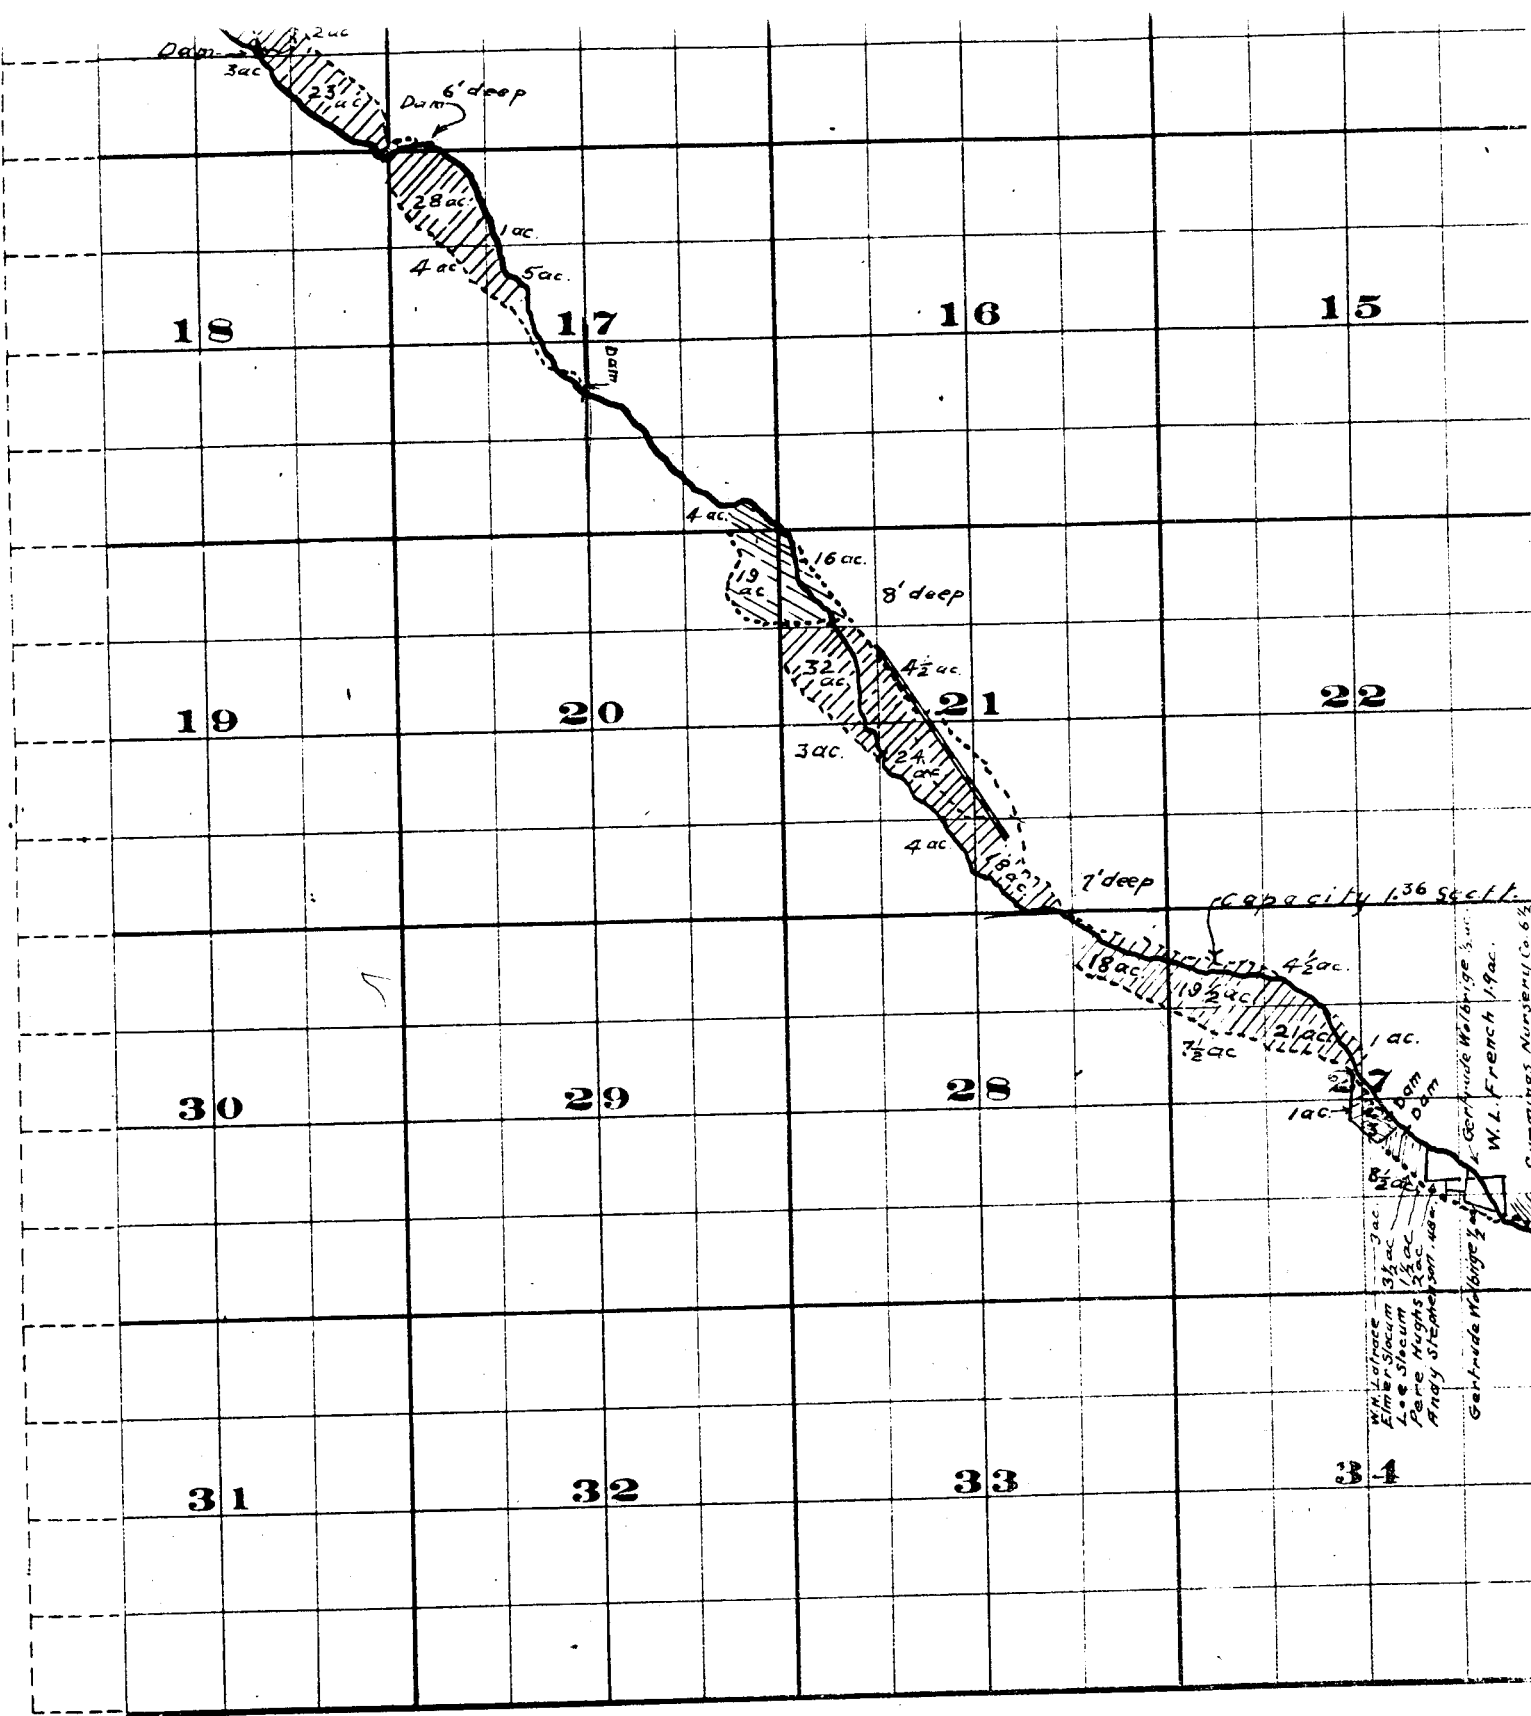

THE B & BRISTOL CO., PRINTERS & BOUNDERS CHICAGO, ILL.

Surveyed by R.D. Cooper July 1909  
 John H. Lewis - State Engineer.  
 Examined July 14, 1909.



