


FROM OFFICE OF THE STATE ENGINEER, SALEM, OREGON

*Willow Creek Adjudication.*

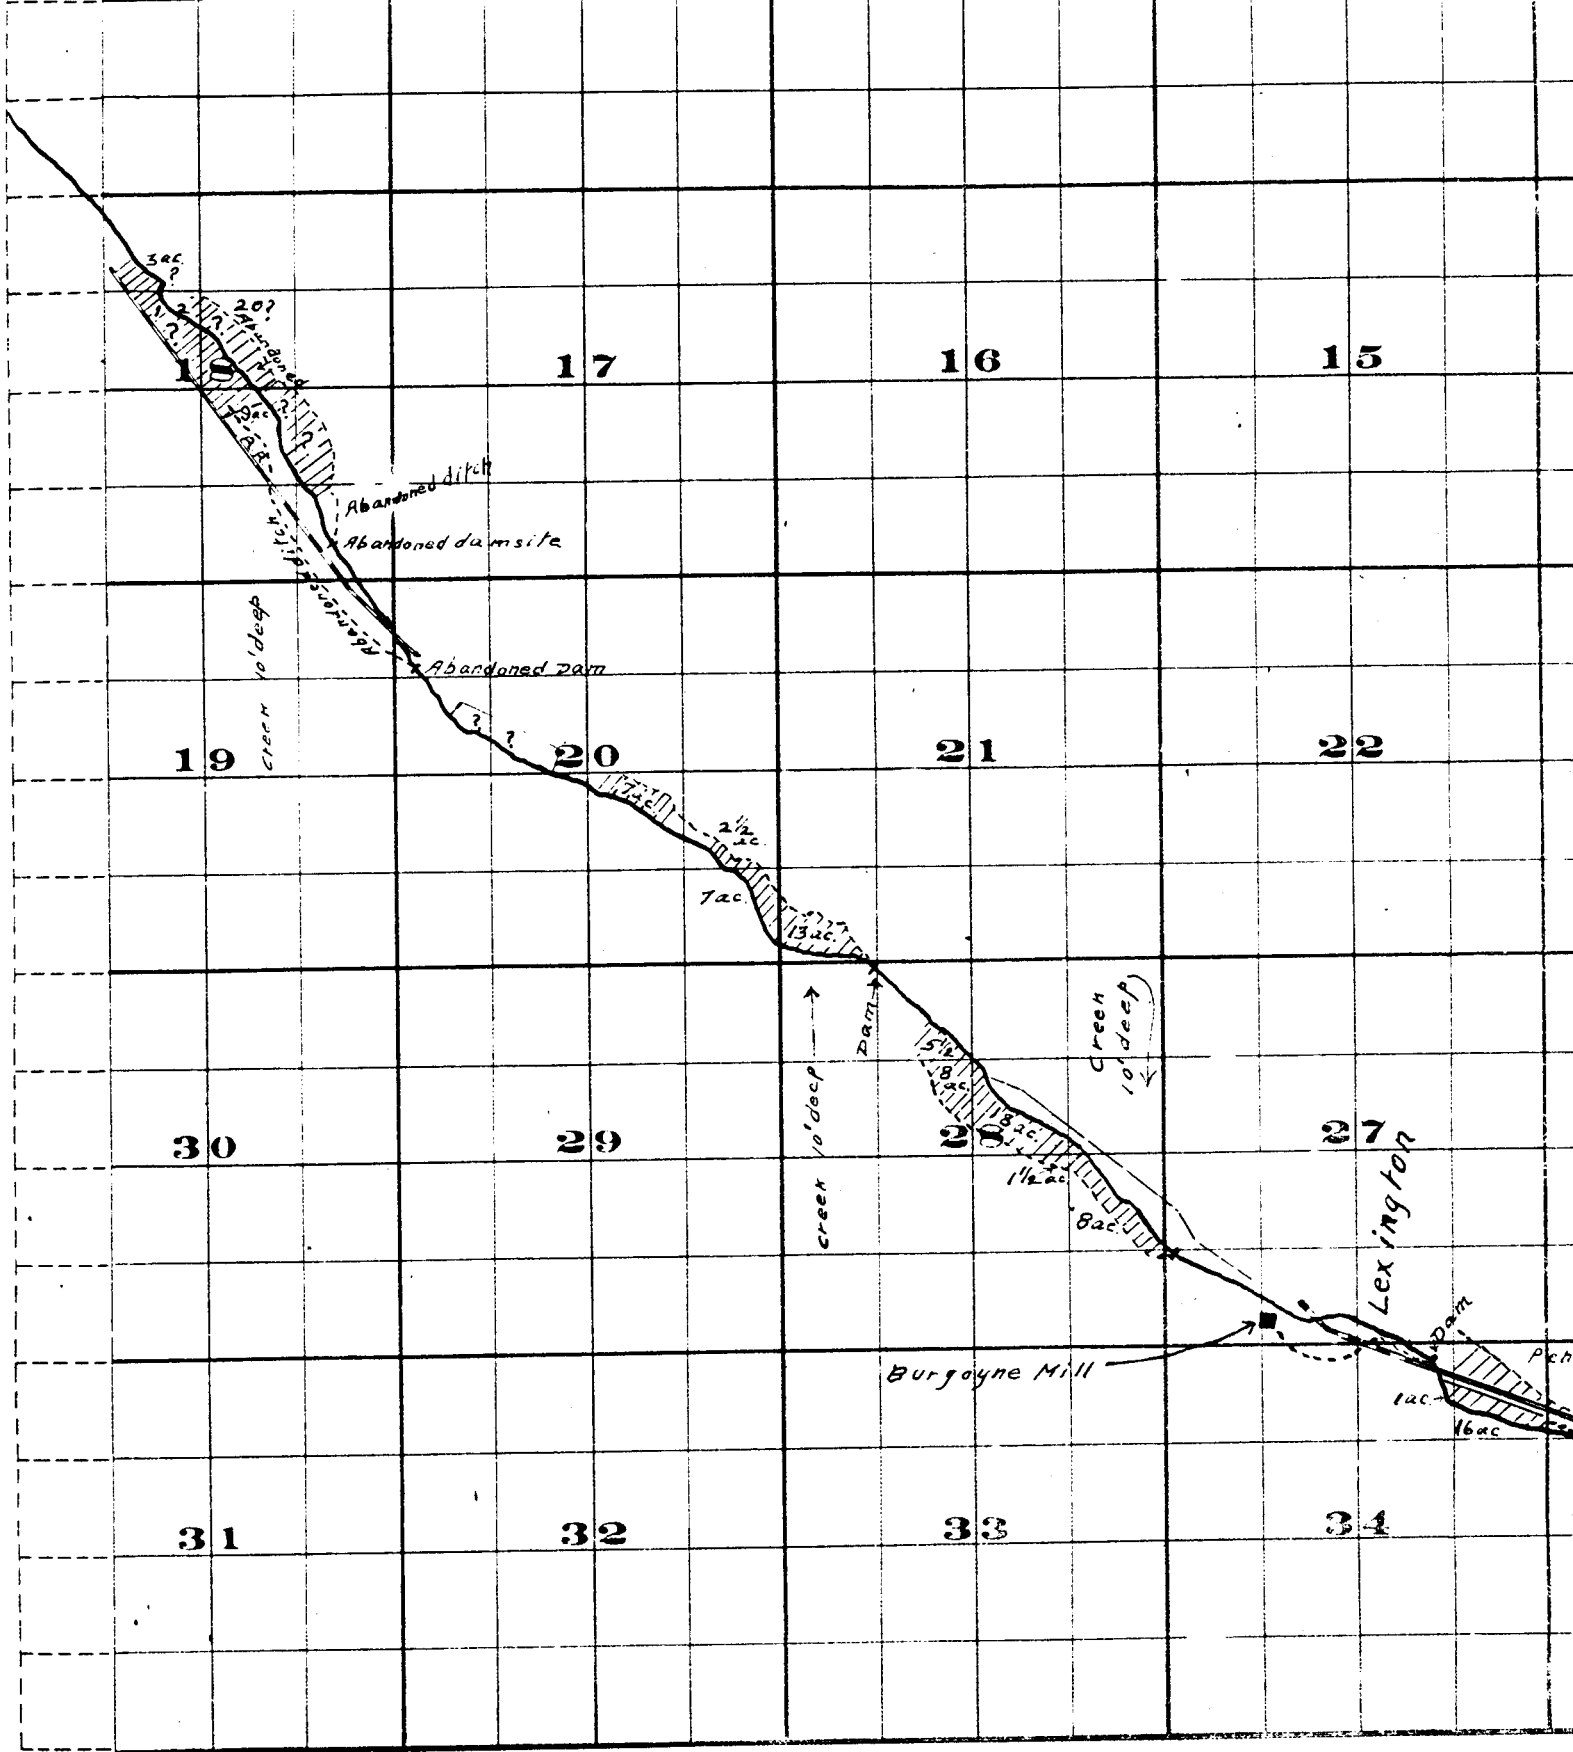

THE S. PRISTOL CO. PRINTERS & RUBBER STAMPS 117 N. 2ND ST.

Surveyed by R.D. Cooper - July 1909

John H. Lewis - State Engineer

Examined July 14, 1909.

Township 1 S. , R:

