




Township 2 N. , Range 23 E. W.M.

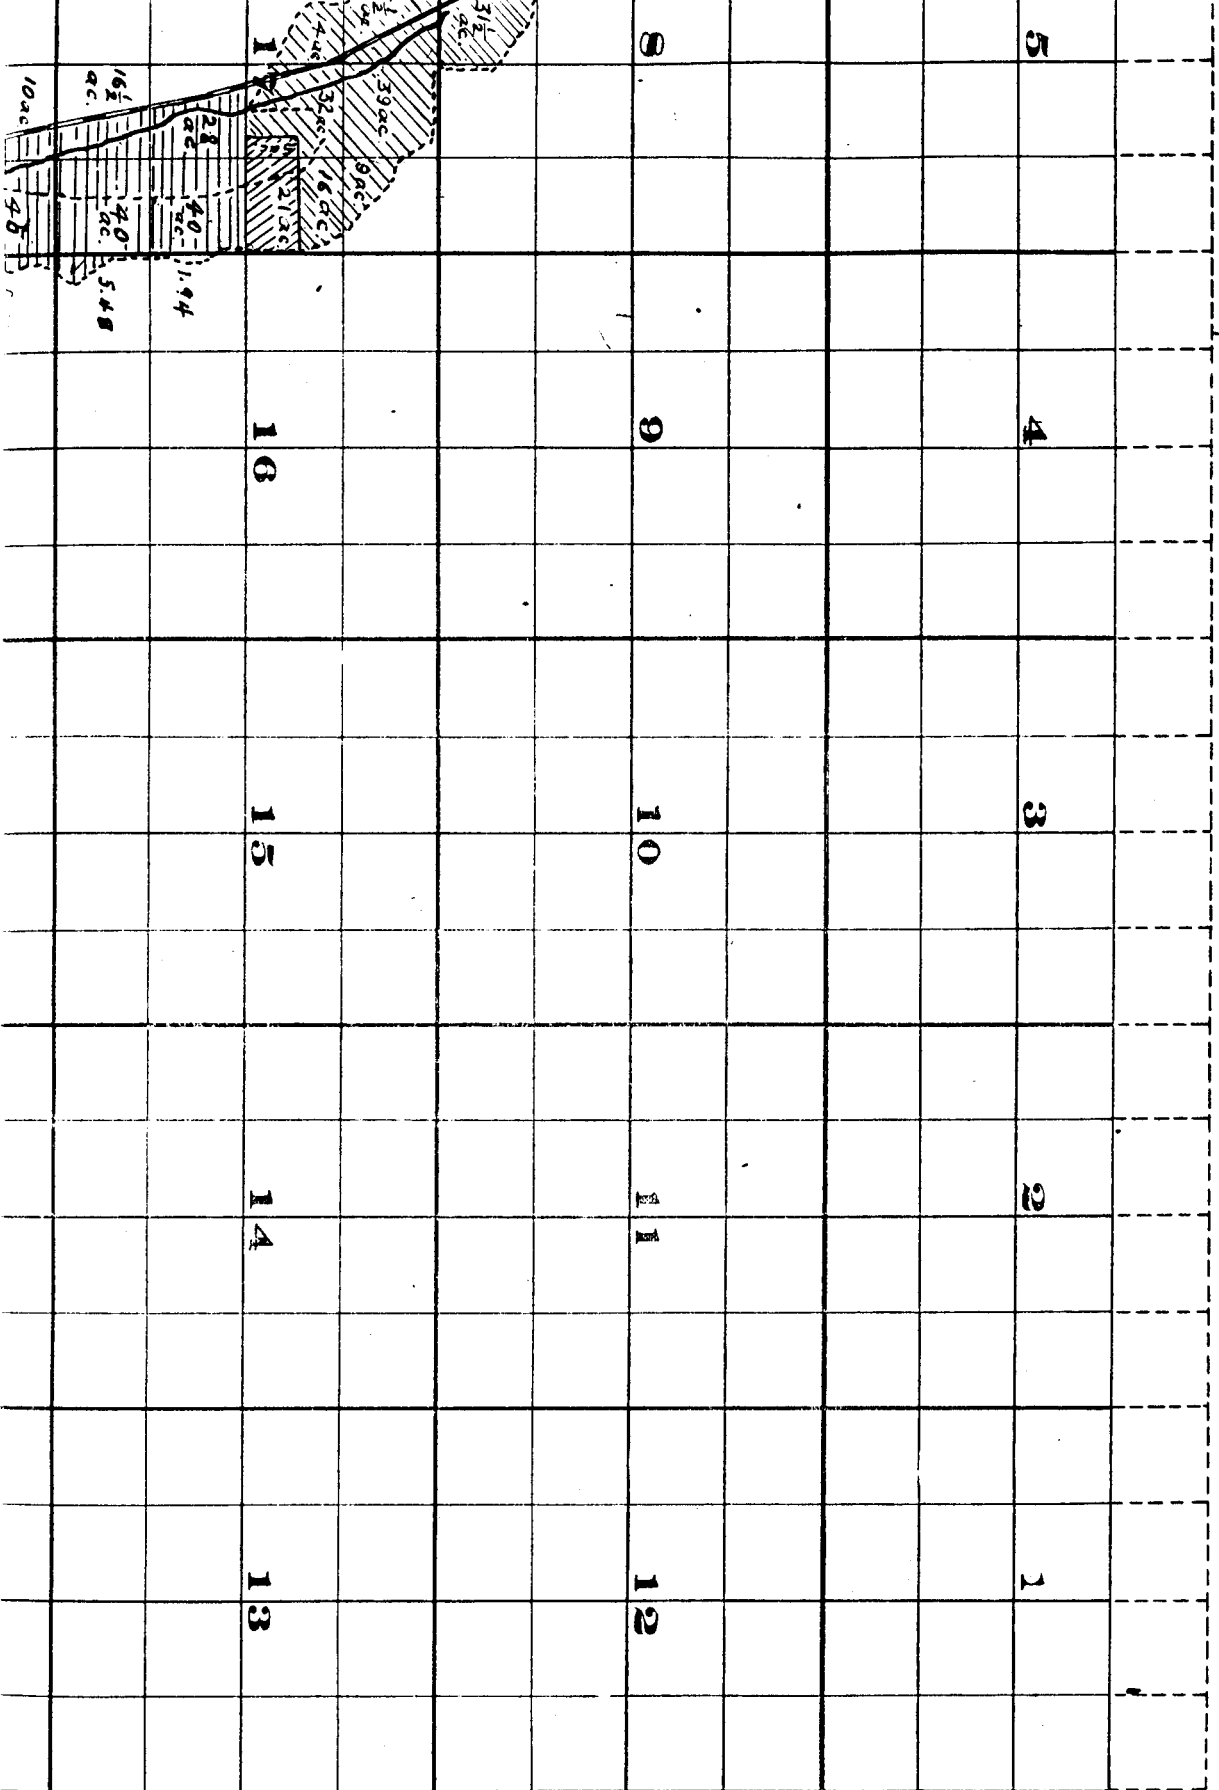

٧

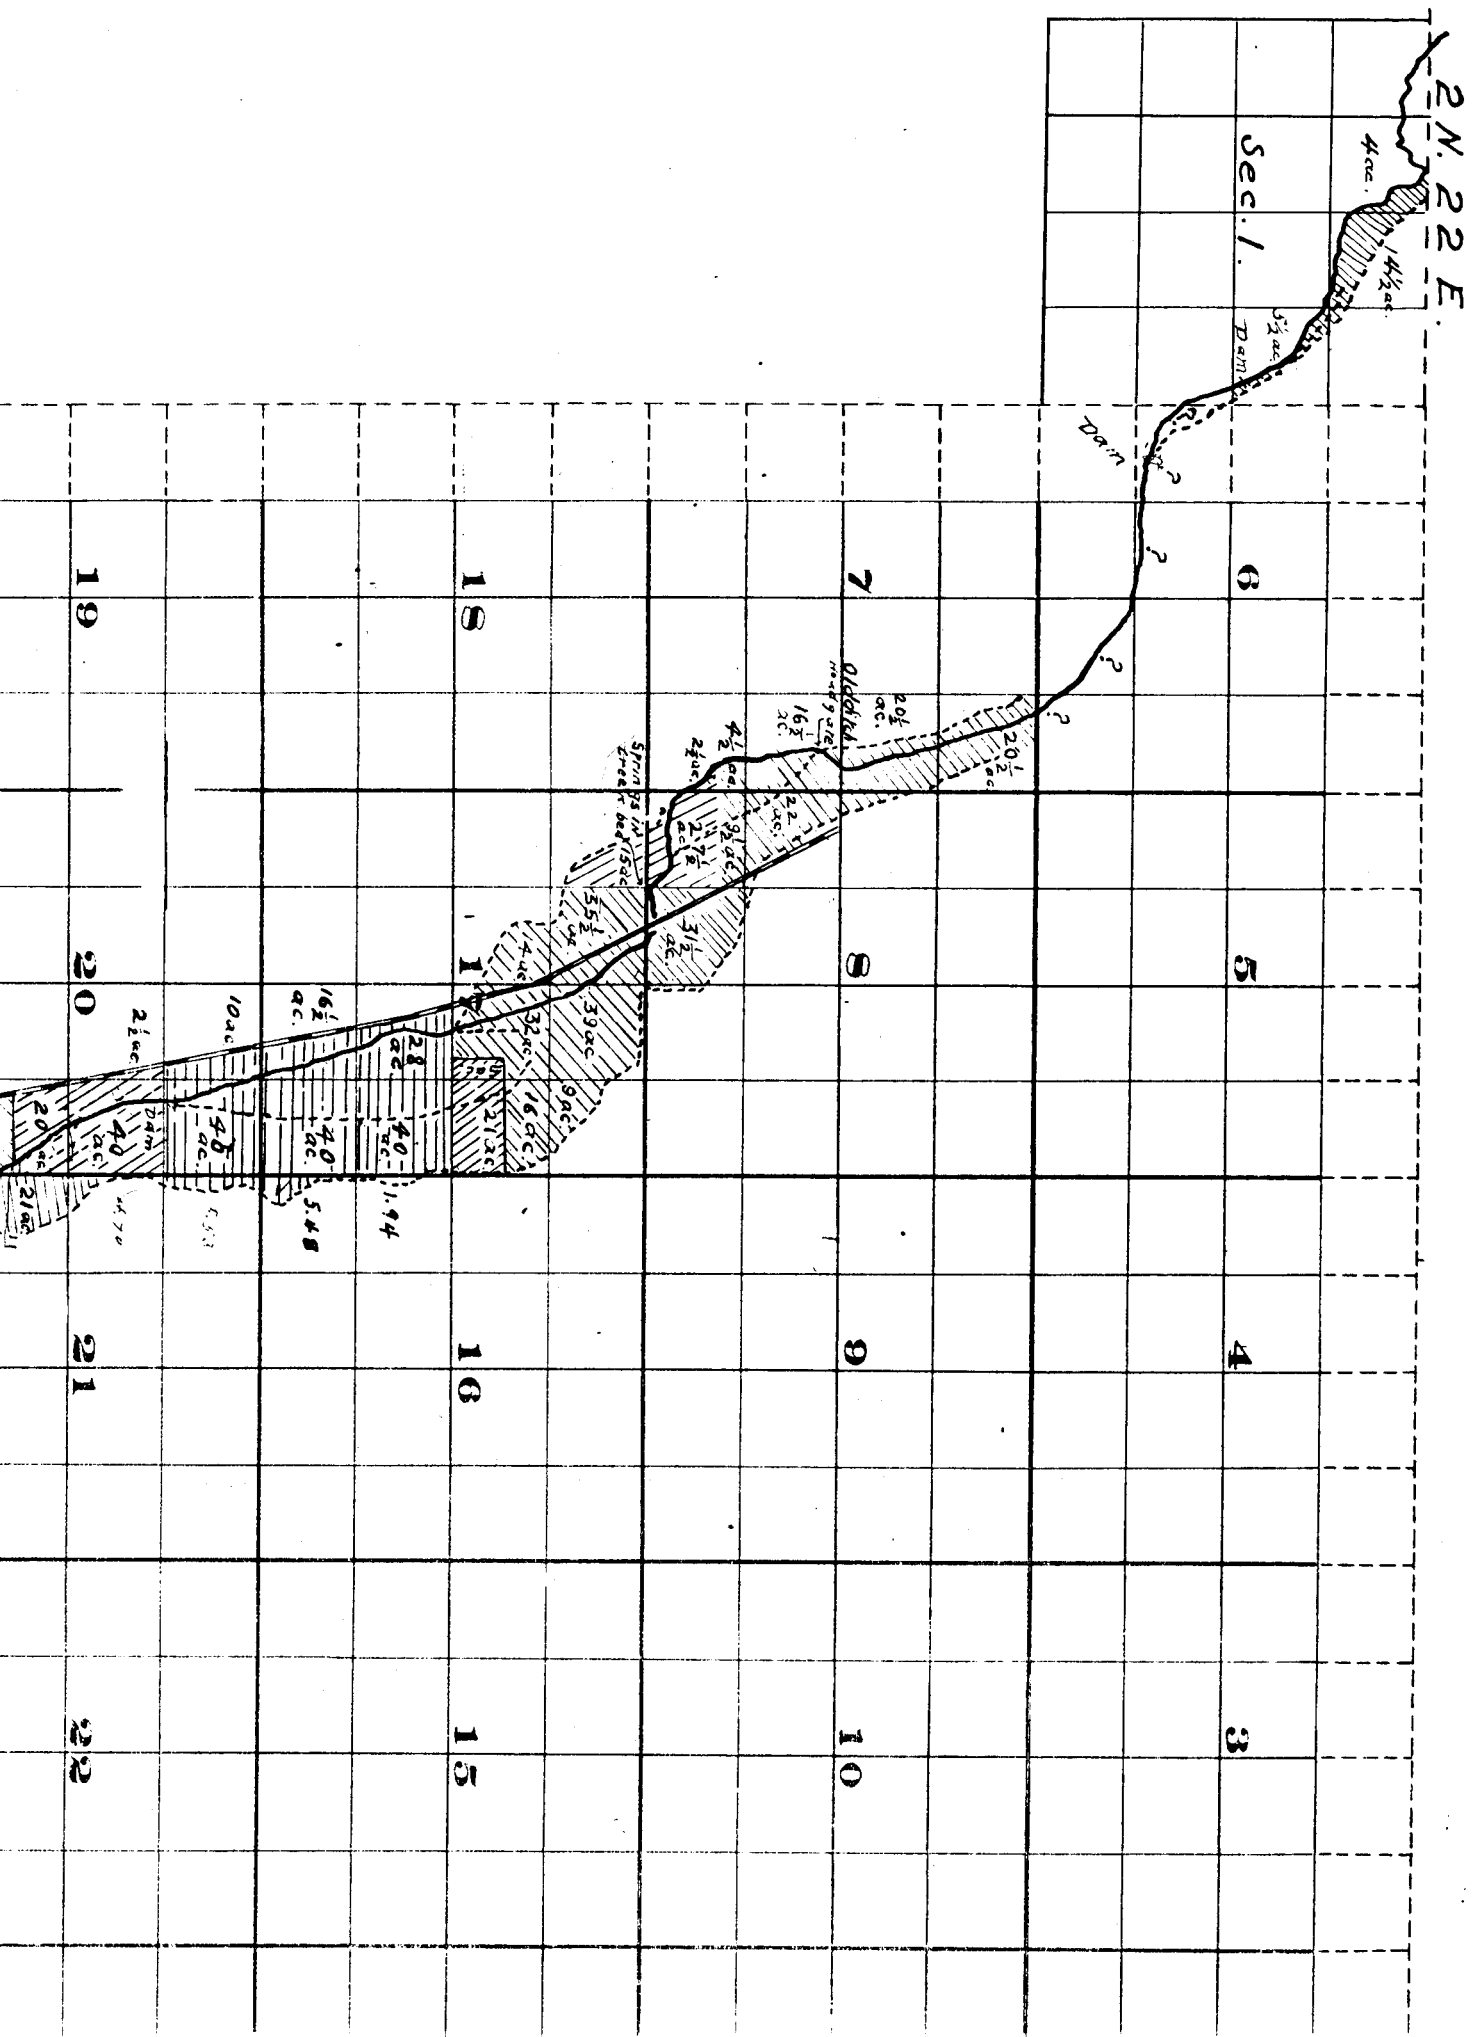

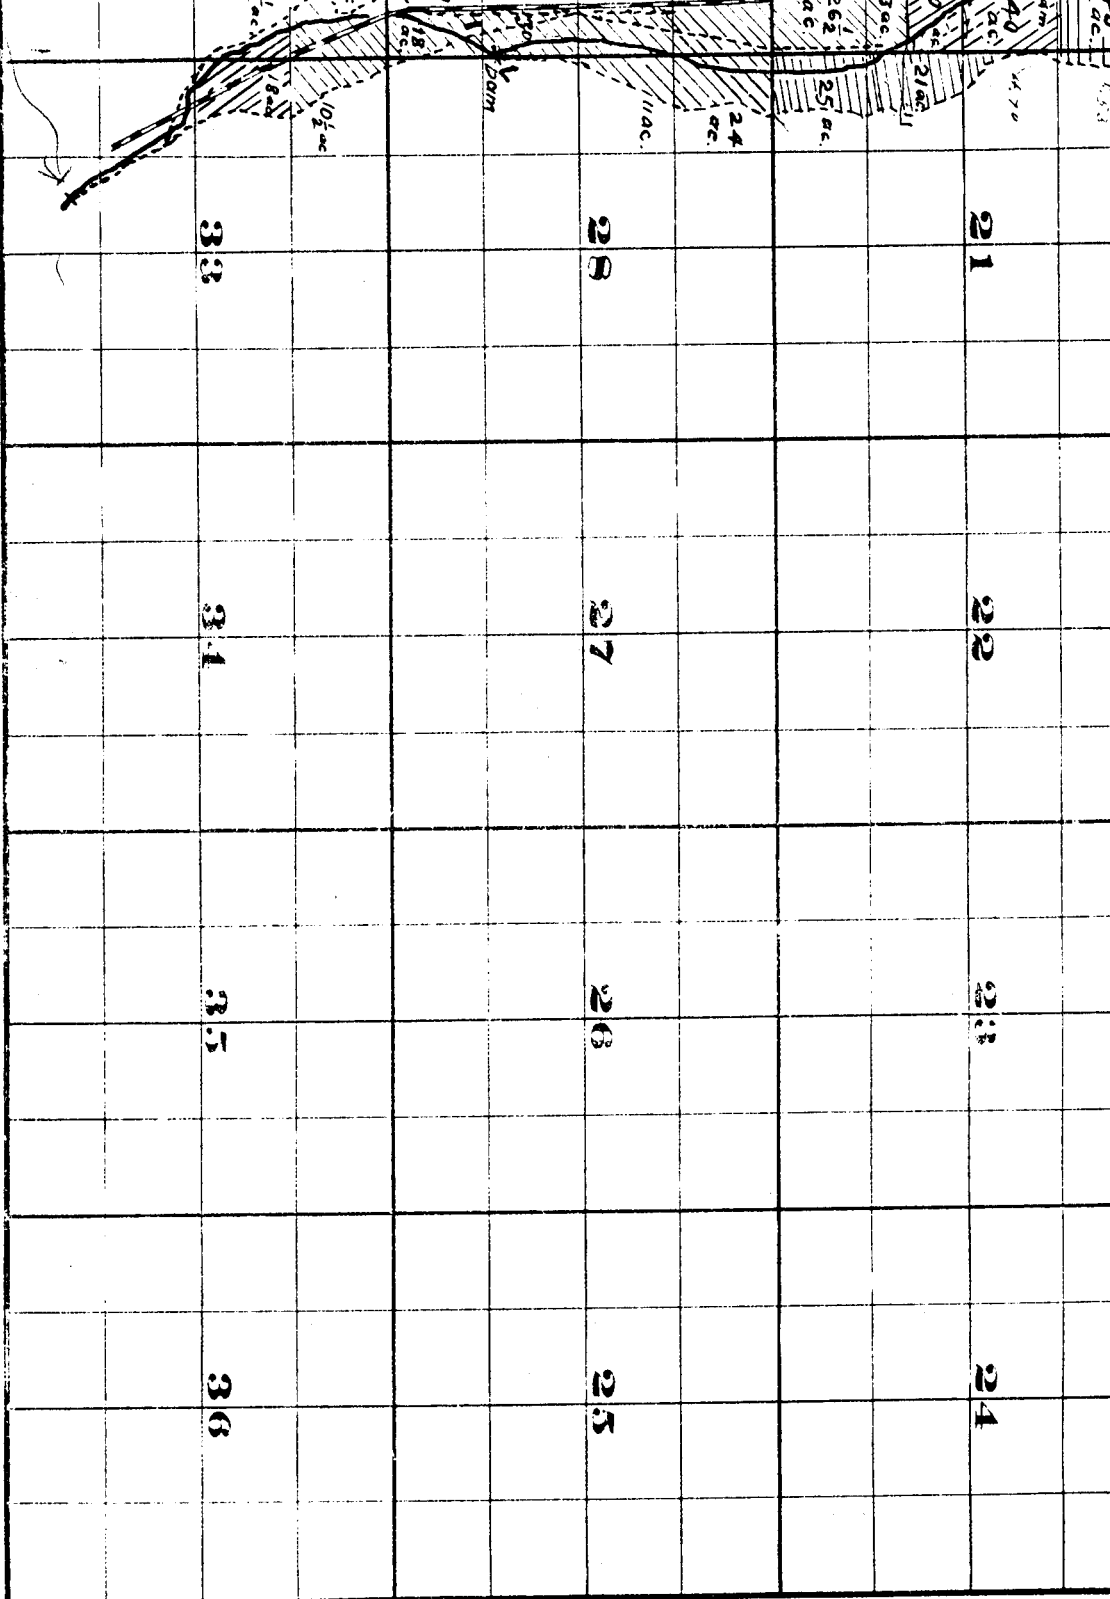

FROM OFFICE OF THE SENIOR ENGINEER, SEASIDE, OREGON

Willow Creek Adjudication.

July 1909.
Senior Engineer.

July 14, 1909.

2 N. 22 E.
2 N. 23 E.