


T.6 S. R.2W.W.M.

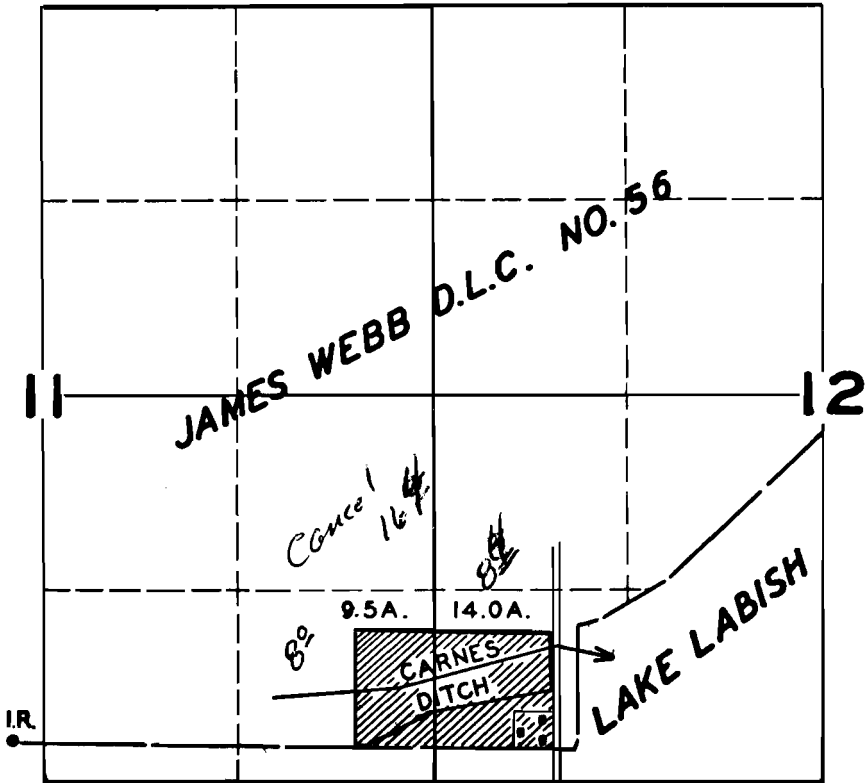

**FINAL PROOF SURVEY**  
UNDER

Application No. 15839 Permit No. 11688  
IN NAME OF

ERNEST L. DUNN

Surveyed APR. 29 1949, by JAS. E. BUNNELL