


T.6S.R.1E.W.M.

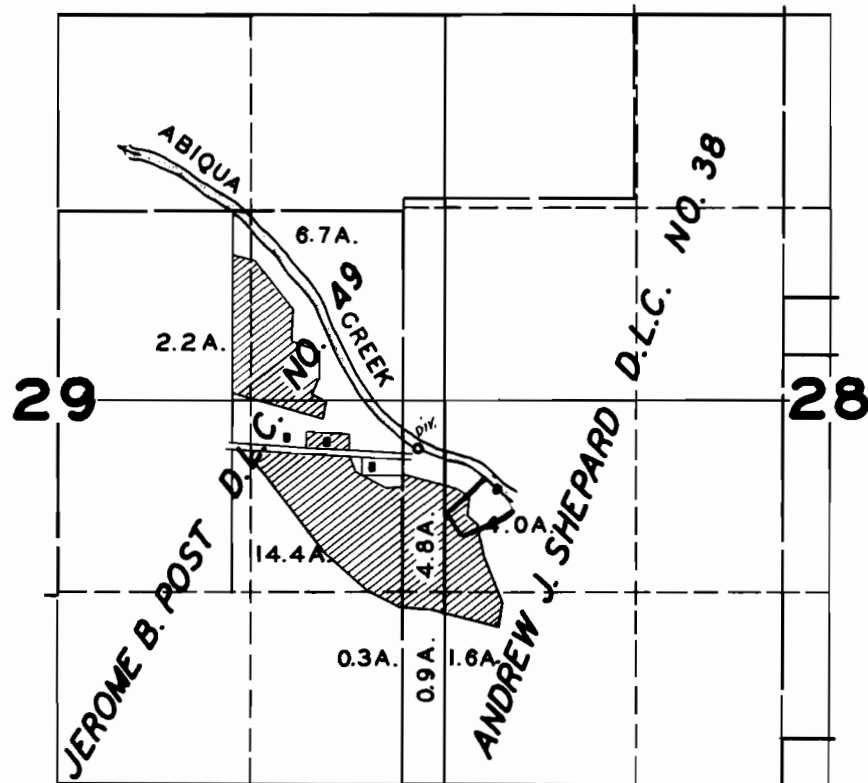

FINAL PROOF SURVEY
UNDER

Application No. 16585 Permit No. 12647
IN NAME OF

MURRAY WINSTEAD

Surveyed APR. 18 1949, by JAS. E. BUNNELL