


T. 7S. R.3W. W.M.

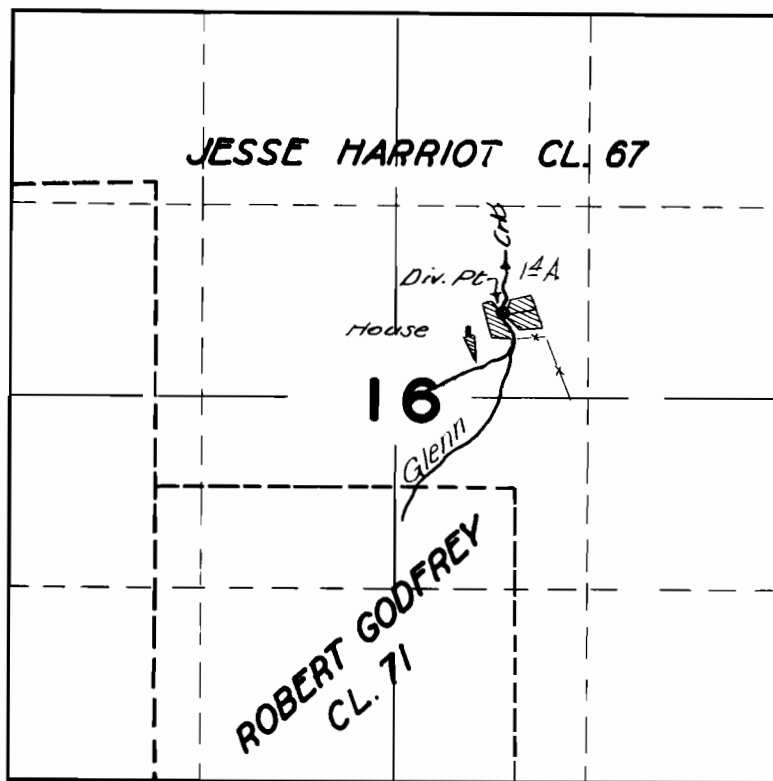

FINAL PROOF SURVEY
UNDER

Application No. 17941 Permit No. 13623
IN NAME OF

DONALD M. FISHER

Surveyed APR. 5, 1950., by H. L. COFFMAN.