


T. 7S. R. 39E. W.M.

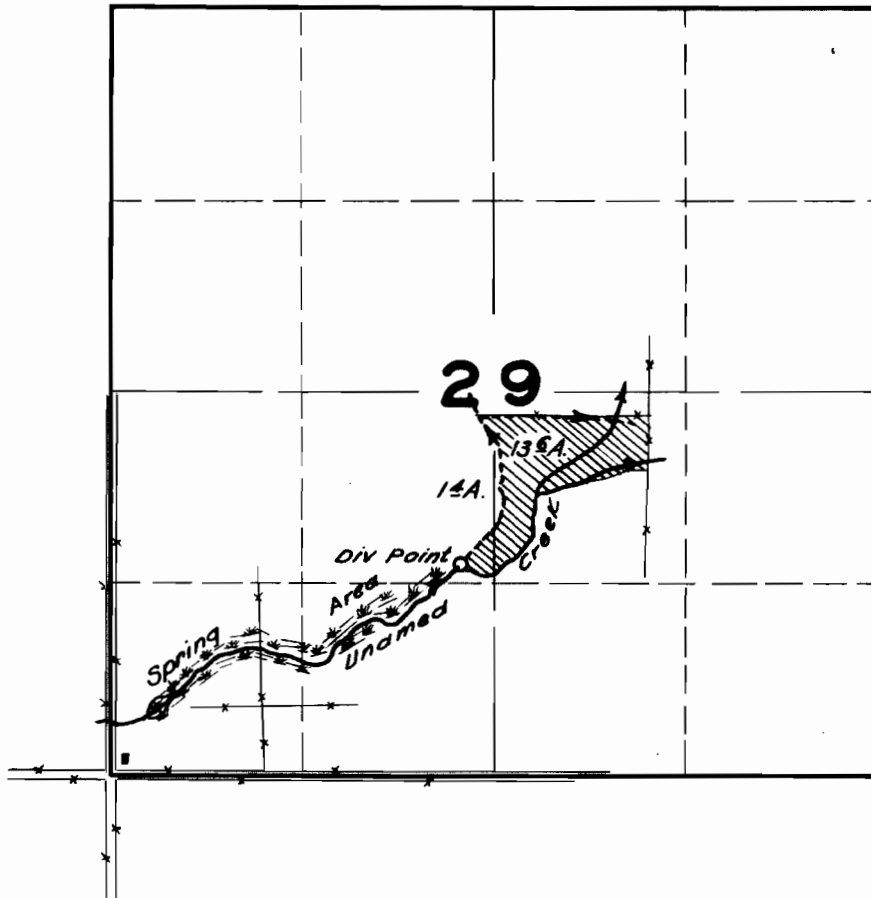

FINAL PROOF SURVEY
UNDER

Application No. **18480** Permit No. **14239**
IN NAME OF

WALTER GOLES

Surveyed **NOV. 25 1949**, by **H.L. COFFMAN**