


# T.6S.R.1E.W.M.

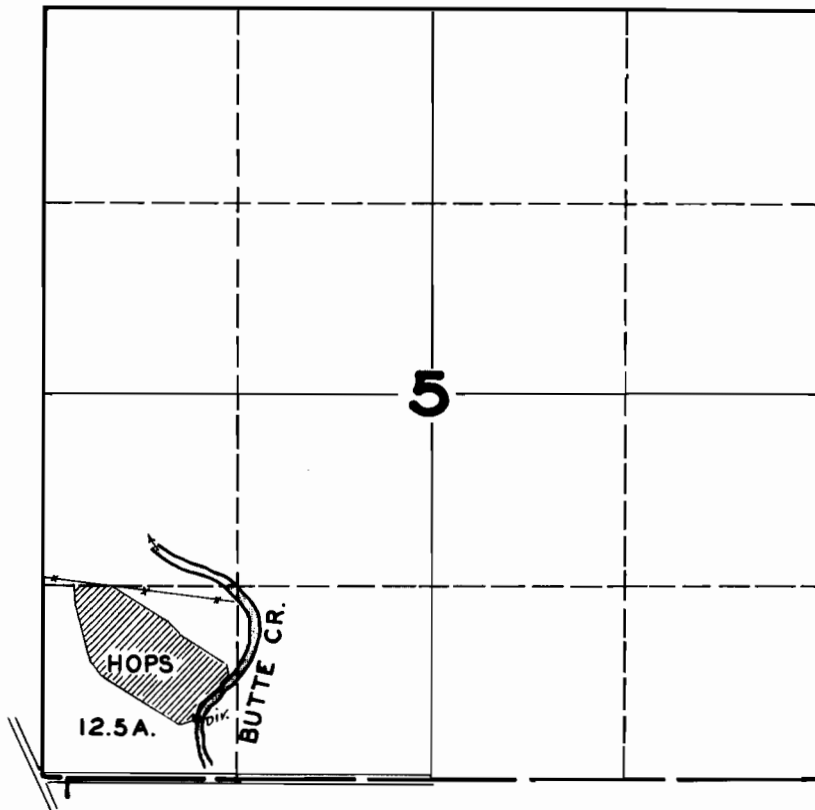

## FINAL PROOF SURVEY

UNDER

Application No. 18950 Permit No. 14552

IN NAME OF

EARL ROSS

Surveyed APR. 19 1949, by JAS. E. BUNNELL