


T. 5 S. 2 E. W. M.

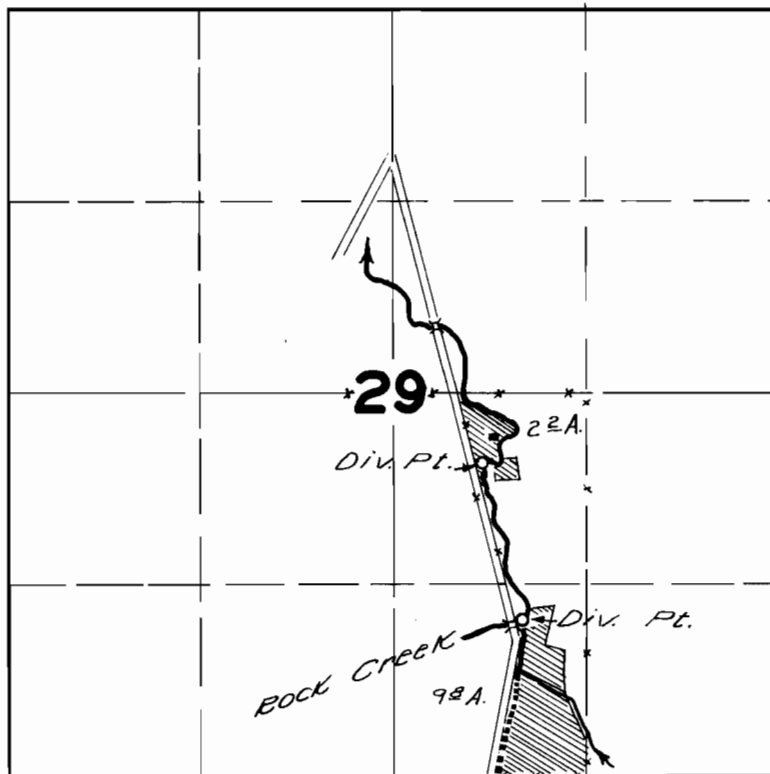

FINAL PROOF SURVEY
UNDER

Application No. **20358** Permit No. **15880**
IN NAME OF

WILLIAM F. SCHAAD

Surveyed **APR. 18 1950**, by **H. L. COFFMAN**