


T. 5S. R. 1 W. W. M.

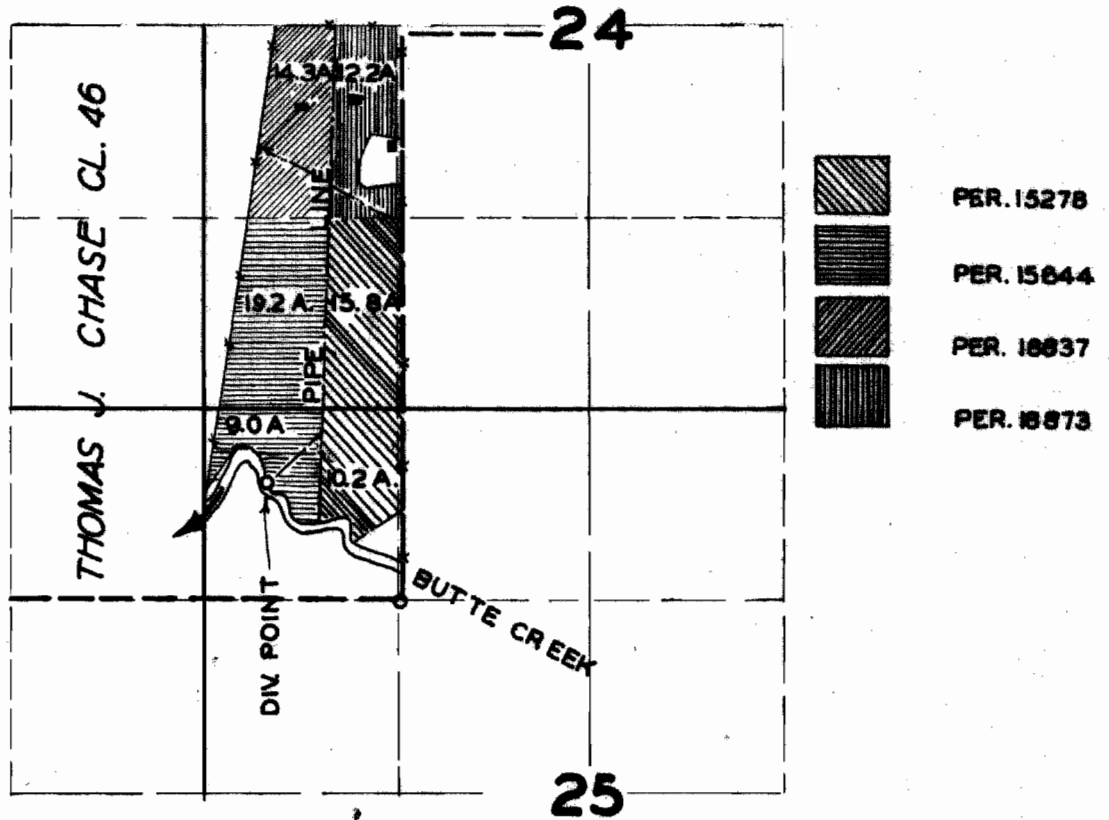

FINAL PROOF SURVEY UNDER

Application No. Permit No.
IN NAME OF

DAVID ELVIN SHATTO AND IRVIN SHATTO

Surveyed APR. 18. 1950. by H.L. COFFMAN