


T. 5S. R. 1 W. W. M.

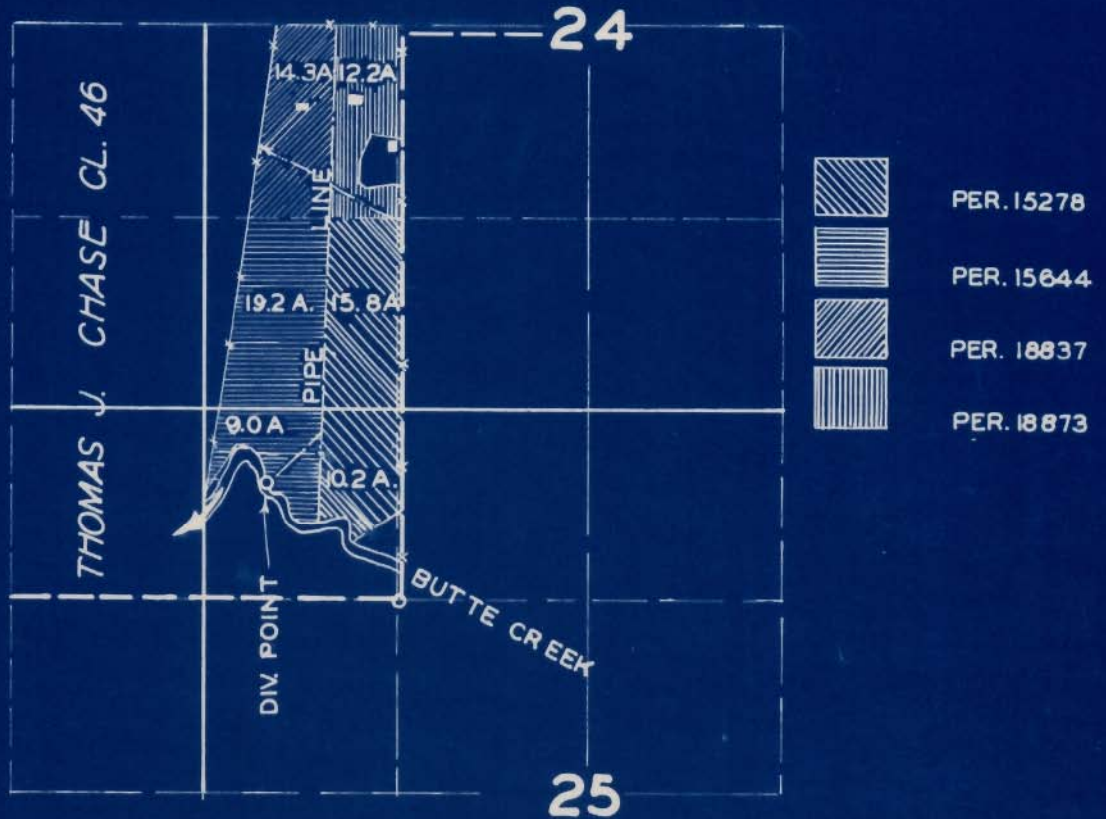

FINAL PROOF SURVEY
UNDER

Application No. 33973 Permit No. 15278
IN NAME OF

DAVID ELVIN SHATTO AND IRVIN SHATTO

Surveyed APR. 18, 1950, by H.L. COFFMAN