


T. 3 S. R. 2 E. W. M.

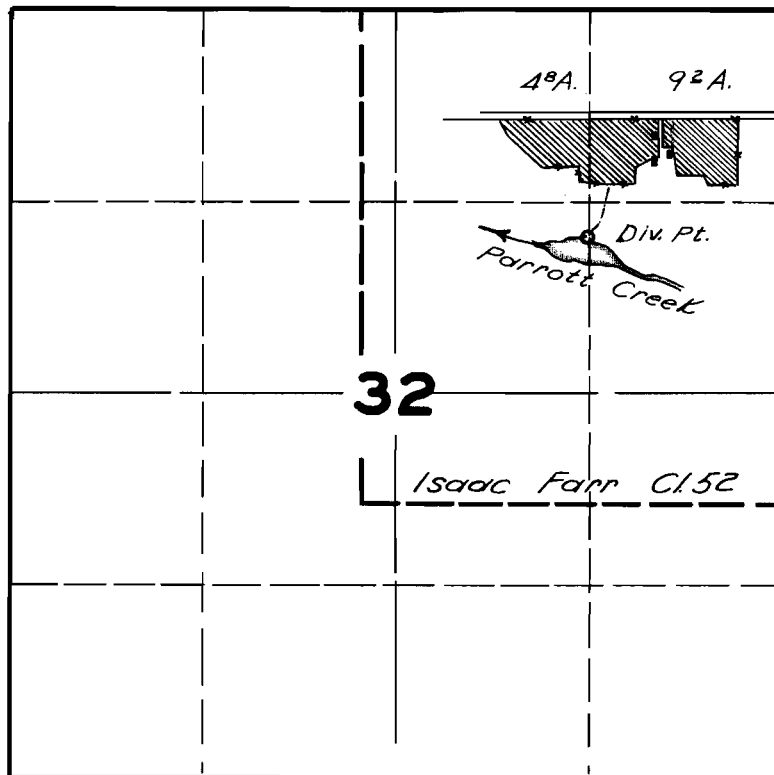

FINAL PROOF SURVEY

UNDER

Application No. 17415 Permit No. 13149
IN NAME OF

..... **ALVA C. HAUN**

Surveyed APR. 24 1950, by H. L. COFFMAN.