


T. 5S. R. 2 E.W.M.

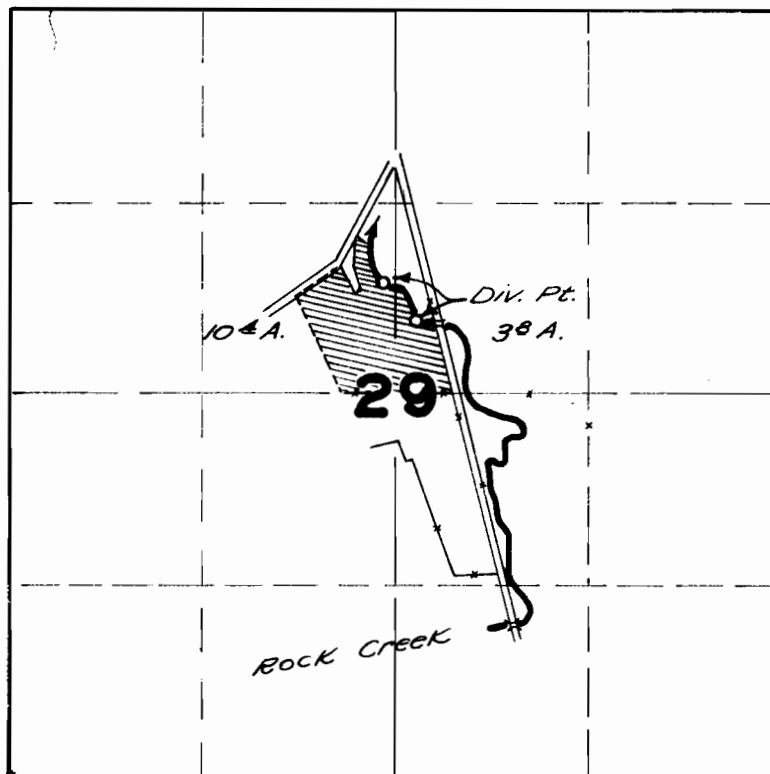

FINAL PROOF SURVEY
UNDER

Application No. **20424** Permit No. **15948**
IN NAME OF

ELMER KIMMEL

Surveyed **APR. 18, 1950**, by **H.L. COFFMAN**.