


T26SR.7W.W.M.

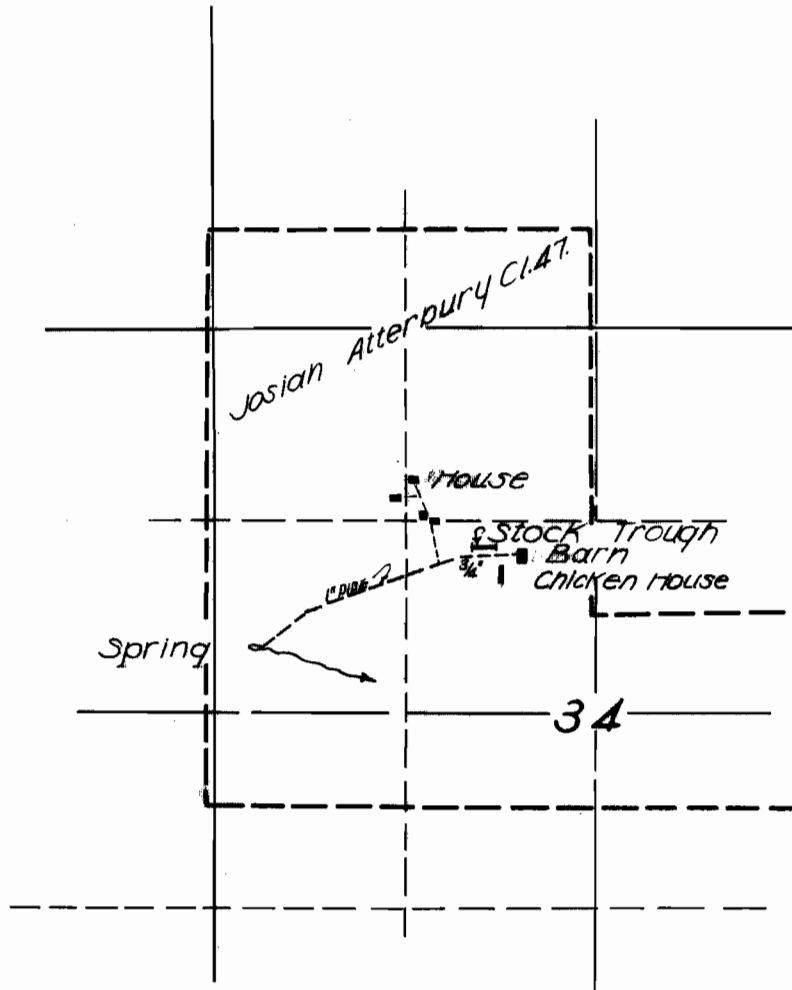

FINAL PROOF SURVEY

UNDER

Application No. ~~20744~~ Permit No. ~~16236~~

IN NAME OF

~~O.M. Durch & W.W. Lucas~~

Surveyed ~~July 1, 1949~~ by ~~H.L. Coffman~~