


T.8S.R.39E.W.M.

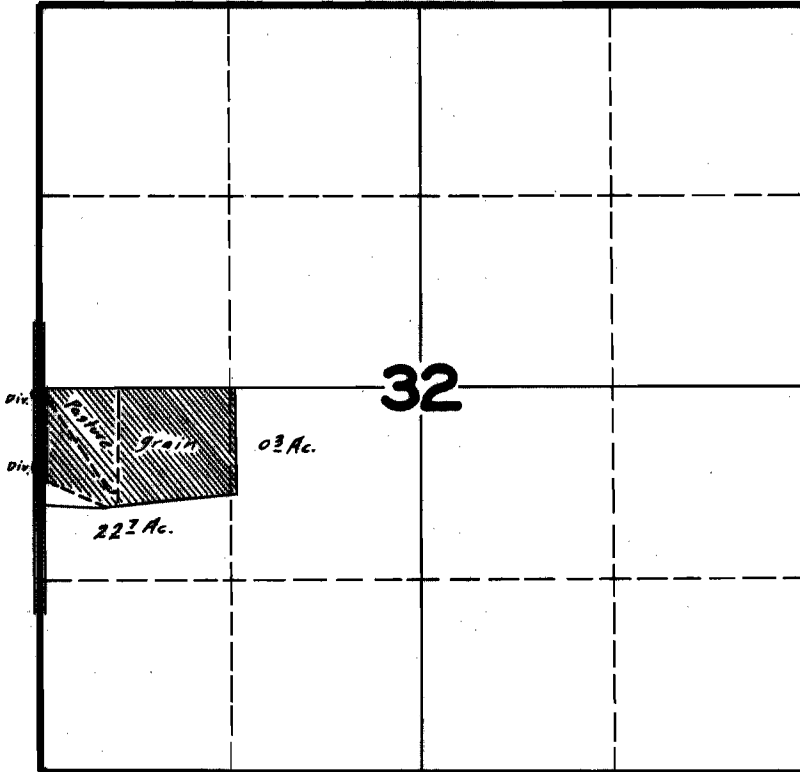

FINAL PROOF SURVEY UNDER

Application No. 20816 Permit No. 16289

IN NAME OF
HAROLD DOHERTY

Surveyed JULY 6 1946, by [Signature]