


T. 3 S. R. 1 E. W. M.

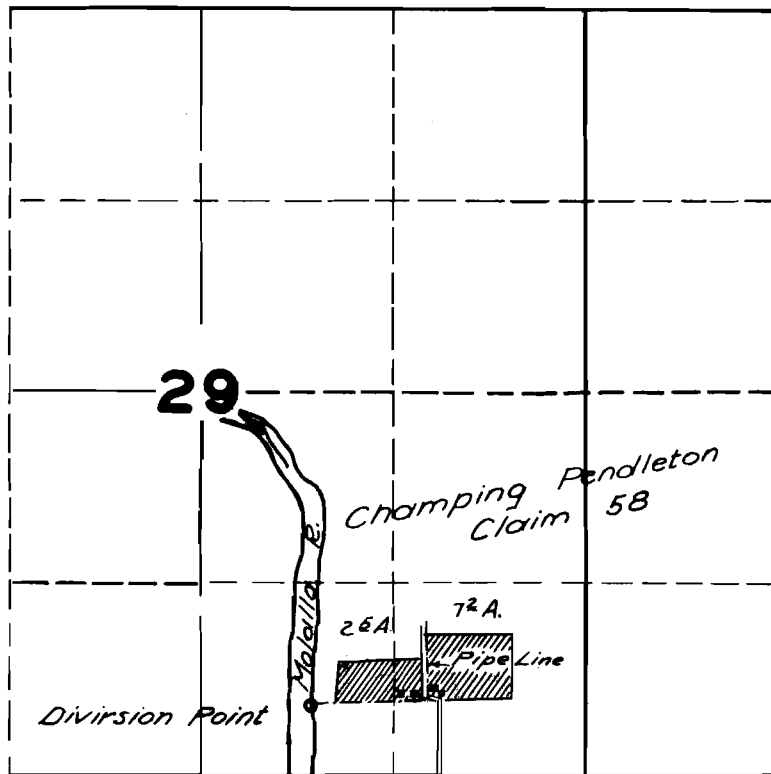

FINAL PROOF SURVEY

UNDER

Application No. 21356 Permit No. 16734

IN NAME OF

HAROLD BIGHAM & J.E. FARNSWORTH

Surveyed APR. 24 1950. by H.L. COFFMAN.