


T. 7 S. R. 4 W W.M.

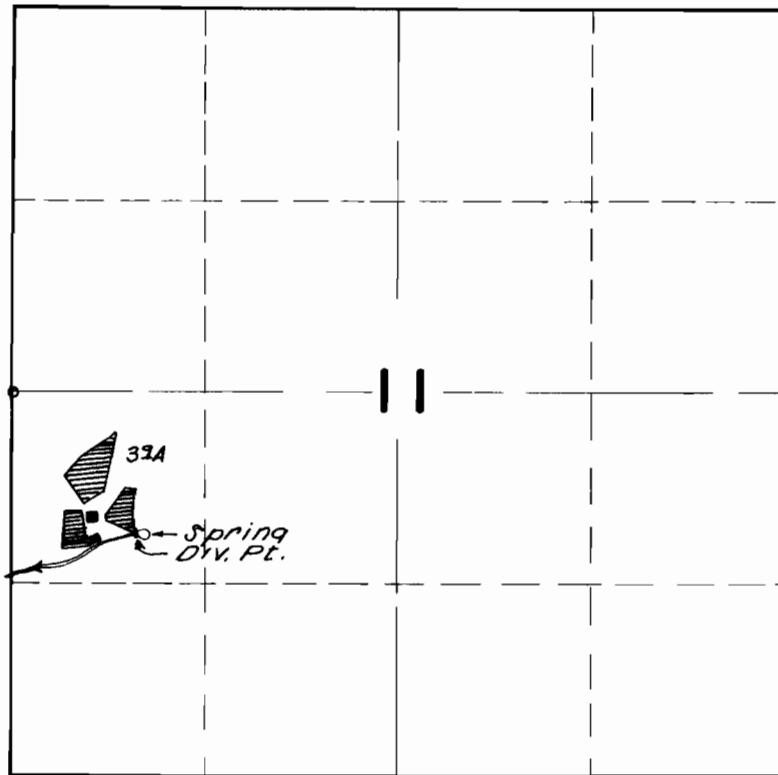

FINAL PROOF SURVEY UNDER

Application No. 16787 Permit No. 12563
IN NAME OF

FRANK C. FITTS

Surveyed APR. 5, 1950, by H.L. COFFMAN