


T. 8S. R. 6W.W.M.

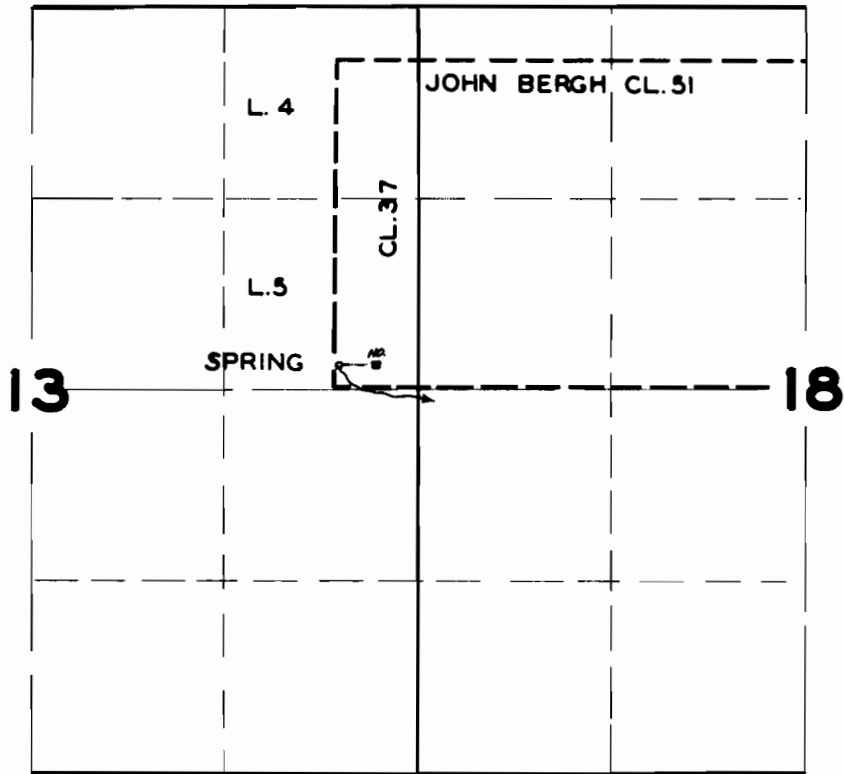

FINAL PROOF SURVEY

UNDER

Application No. **21674** .. Permit No. **17021**..

IN NAME OF

P.O. OTTOWAY

Surveyed **APR. 11 1950**, by **H.L. COFFMAN**..