


T. 4 S. R. 1 E. W. M.

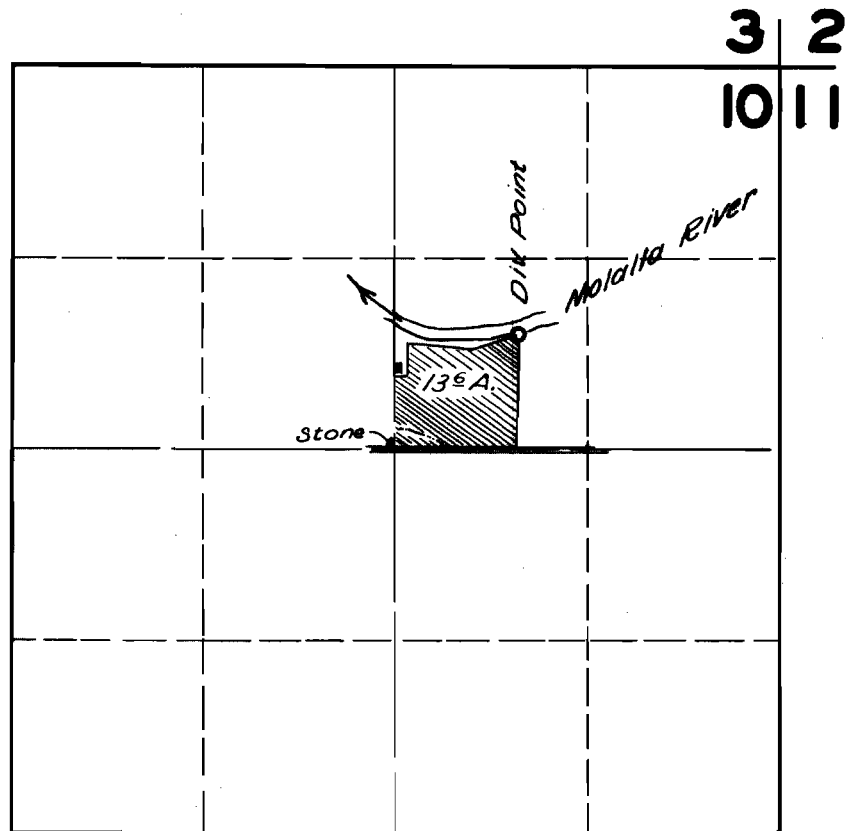

FINAL PROOF SURVEY
UNDER

Application No. **21894**. Permit No. **17240**.
IN NAME OF

EDWARD C. DASSO

Surveyed **APR. 26 1950**, by **HL. COFFMAN**.