


T.7S. R.3W.W.M.

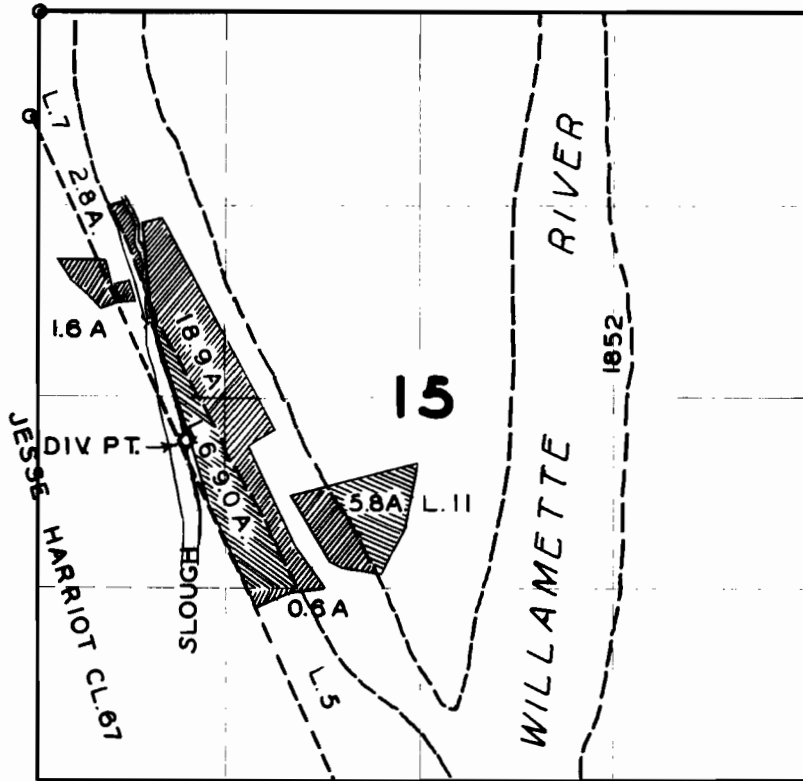

FINAL PROOF SURVEY
UNDER

Application No. 21701... Permit No. 17093
IN NAME OF

.....**W. LEO NELSON**.....

Surveyed APR. 6. 1950. by H.L. COFFMAN.