


T.8S. R.1W.W.M.

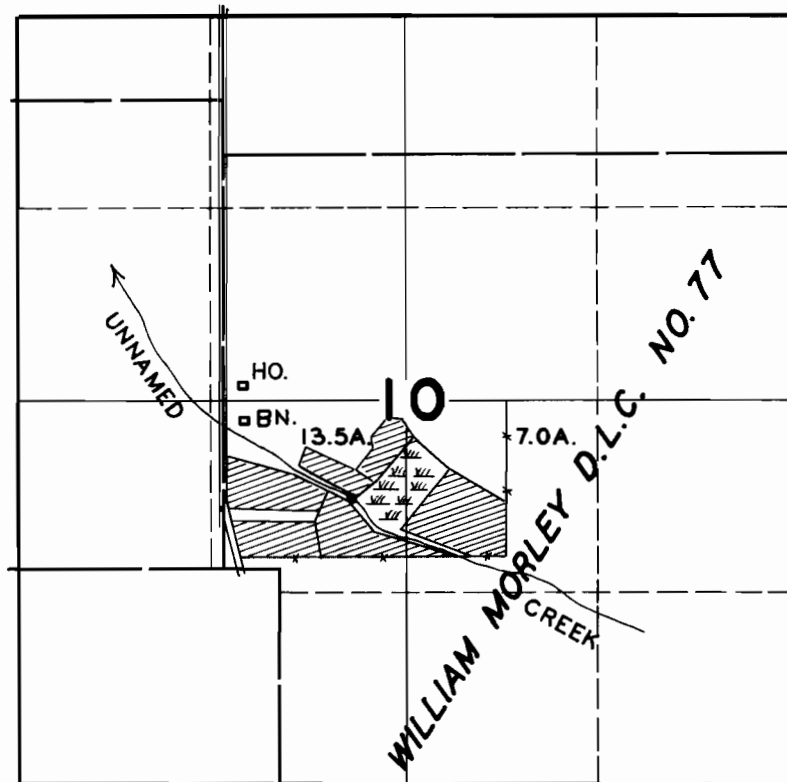

FINAL PROOF SURVEY
UNDER

Application No. 21883 Permit No. 17234
IN NAME OF

EDWARD EBNER

Surveyed APR. 1 1949, by JAS. E. BUNNELL