


T.30S.R.6W.W.M.

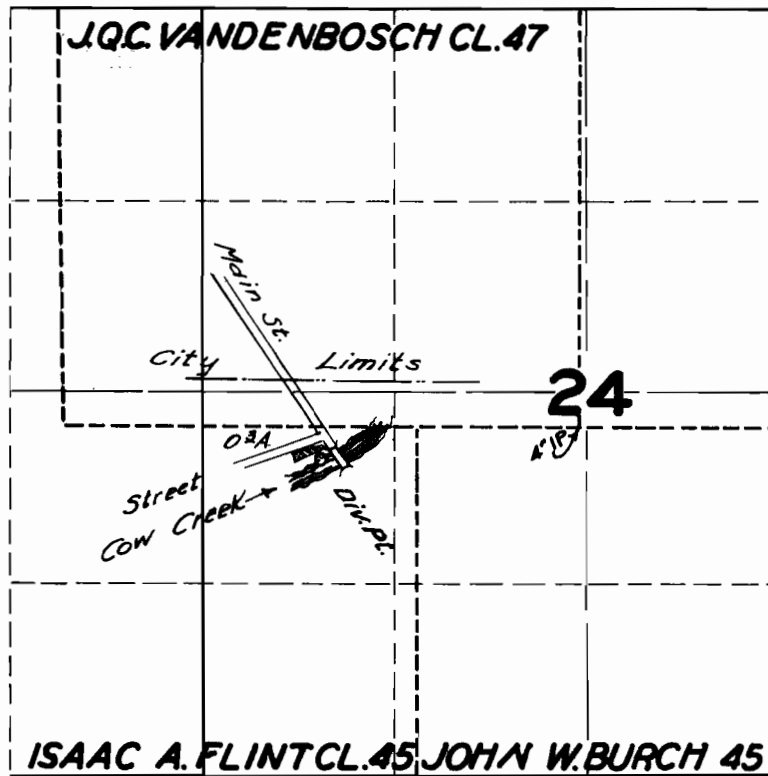

FINAL PROOF SURVEY

UNDER

Application No. **22054** Permit No. **17314**....

IN NAME OF

E.E. HART

Surveyed **JULY 29 1949**., by **H.L. COFFMAN**..