


T. 3 S. R. 4 W. W. M.

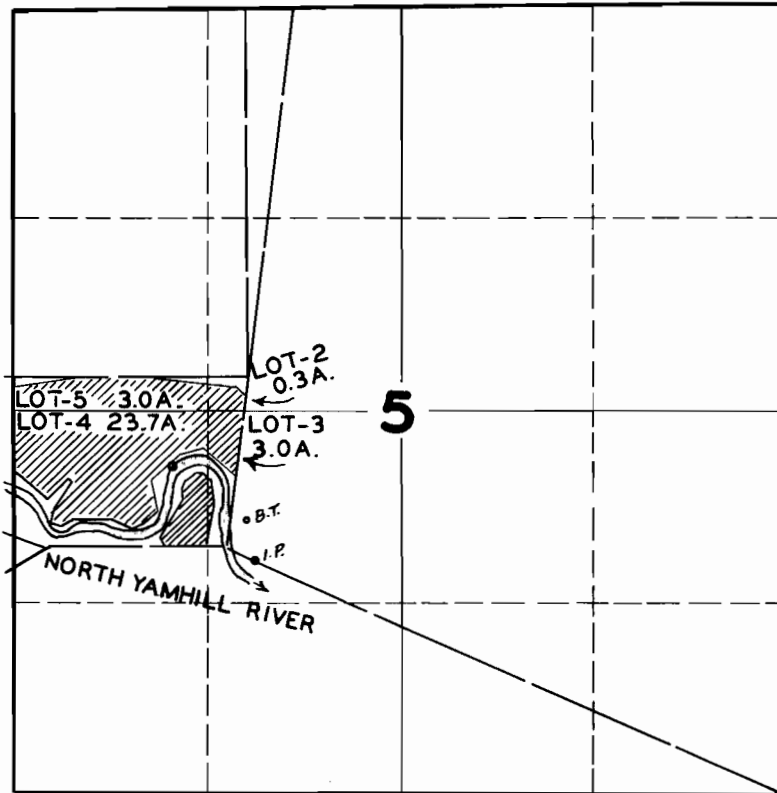

FINAL PROOF SURVEY UNDER

Application No. 22040. Permit No. 17325....
IN NAME OF

..... LEO R. MORRIS

Surveyed MAY 4, 1949, by JAS. E. BUNNELL