


T.22S. R.3W.W.M.

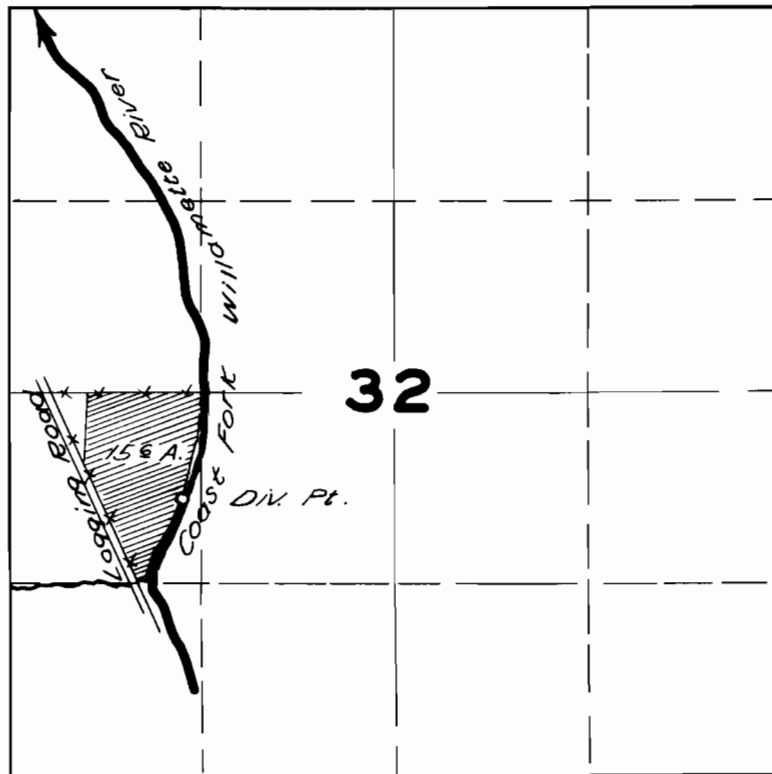

FINAL PROOF SURVEY

UNDER

Application No. **22091**. Permit No. **17368**...
IN NAME OF

SAM F. MEDFORD & ANNIE L. MEDFORD.

Surveyed **MAY 4, 1950**, by **H.L. COFFMAN.**